ADAMS COUNTY COUNTY CORNER NO: 85

ROMPORTOL ID: 41605200000

PUBLIC LAND SURVEY MONUMENT RECORD

HARRISON (BROKEN-TOP) TYPE OF MONUMENT:_ ADAMS COUNTY COORDINATES, NAD 83 (2007) N. 175317.212 E. 504636.350 ELEVATION- - - -DATUM FIELD WORK DATE: 02/16/2021

BASIS FOR MONUMENT LOCATION

1979 - PLS 878 EXCAVATED WITH BACKHOE, FOUND NOTHING, STONES WERE FOUND AT THE NE, W1/4, SE, AND S1/4 CORNERS OF SECTION 21. STRAIGHT LINES WERE RUN THROUGH THESE POINTS TO INTERSECT AT THIS CORNER. NO RECORD OF ANY RESURVEYS (POST, NOT STONE AT W1/4 CORNER)

2021 - PLS 2675 FOUND MAGNAIL IN THE ROAD SURFACE, REMOVED, AND FOUND HARRISON (BROKEN-TOP) 12"± BELOW THE ROAD SURFACE AND 1 WITNESS. THE MONUMENT AGREES WITH THE WITNESS. ACCEPTED THE HARRISON (BROKEN-TOP) AS THE CORNER LOCATION. SET 4 NEW TIES AND MEASURED TO THE EXISTING WITNESS.



(INDICATE CORNER BY "X")




DATA SHOWN HERE ON THIS TIE SHEET IS CORRECT AND COMPLETE TO THE BEST OF MY KNOWLEDGE AND BELIEF.

PROFESSIONAL LAND SURVEYOR 2021

-TIE SKETCH -

NOTE: THE CORNER LANDS 1.5'± NORTH OF EMBER AVE. CENTERLINE AND 4.5'± WEST OF 18TH AVE. CENTERLINE.



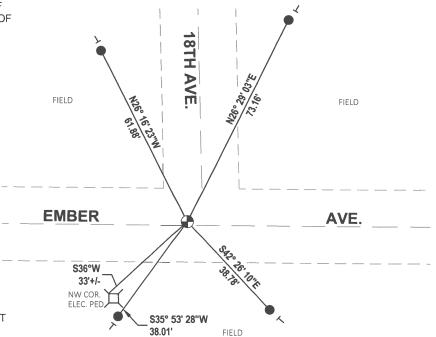

- SET 3/4" x 18" IRON REBAR, 1.50#/FT
 - FOUND HARRISON (BROKEN-TOP) MONUMENT
- VINYL "T" POST

Government Land Corner Certificate	0 K
ADAMS County TYPE OF MONUMENT: STANDARD HARRISON STATE PLANE COORDINATES: N E ELEVATION — M.S.L. DATUM: THETA ANGLE:	CORNER NO SECTION TOWN
FIELD BOOK: 77 PAGE 6 DRAWN BY: PAUL KIEPROWSKI	
BASIS FOR MONUMENT LOCATION Show info such as: History of corner, with reference to Vol. and pg., dates, surveyor; exact description of monument replaced; if location computed, by taped or EDM traverse; landowner remarks, etc. (Use reverse side if necessary)	LOCATION (Indicated by 'X')
Excavated with backhoe. Found Nothing. In Stones were found at the NE, W4, SE, and S4 corners of section 21. Straight lines were run through these points to intersect at this corner. No record of any resurveys. (Post, not stone at W4 corner) ALL OK 4/15/85 D.K.	ANTHONY B. KIEDROWSKI S-878 Wisconsin Rapids, Wis. DATA SHOWN HERE ON
	CERTIFIED CORRECT: 6/13/79 Registered Land Surveyor DATE:
TIE SKETCH Show at least four ties, also fence lines, roads, topo, size and type of witness trees' and if off road - best way to arrive at corner.	S 16" WHITE OAK
EMBER SO AVE	651 RT
Nw. coe of	CLACK 12" BLACK OAK AK BT

MAINTENANCE RECORD

DATE	BY WHOM	REMARKS
10/2/80	KV-SK	COR. OK
2-8-90	KZ-55	ALL OK
2-7-95	J &	ALL OK
2-10-00	TW. S.S.	ALL OK + 2 NEW
3-3-05	5,5-J.S.	ALL OK
7-7-10	55	OK
	0.0	