TOWN

O5 RANGE ADAMS COUNTY C

PUBLIC LAND SURVEY MONUMENT RECORD

TYPE OF MONUMENT: 2-3/8" O.D. IRON PIPE WITH ALUMINUM CAP ADAMS COUNTY COORDINATES, NAD 83 (2007)

N. 175278.589

E. 517897.777


DATUM

FIELD WORK DATE: 01/21/2021


BASIS FOR MONUMENT LOCATION

1981 - PLS 1444 THIS CORNER WAS SET EQUIDISTANT AND ON A STRAIGHT LINE BETWEEN SECTION CORNERS. NO EVIDENCE OF THE ORIGINAL CORNER OR ANY RESURVEY CORNER WAS FOUND.

2021 - PLS 2675 FOUND 2-3/8" O.D. IRON PIPE WITH ALUMINUM CAP UP 18"± AND ALL 4 TIES. THE MONUMENT AGREES WITH ALL 4 TIES. ACCEPTED THE 2-3/8" O.D. IRON PIPE WITH ALUMINUM CAP AS THE CORNER LOCATION. MEASURED TO ALL FOUND IRON PIPES.

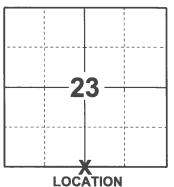

(INDICATE CORNER BY "X")

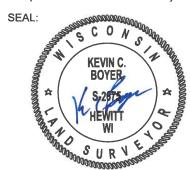

DATA SHOWN HERE ON THIS TIE SHEET IS CORRECT AND COMPLETE TO THE BEST OF MY KNOWLEDGE AND BELIEF.


PROFESSIQNAL, LAND SURVEYOR

12021

-TIE SKETCH



- SET 3/4" x 18" IRON REBAR, 1.50#/FT
- FOUND 1-1/4" O.D. IRON PIPE
- FOUND 2-3/8" O.D.IRON PIPE WITH ALUMINUM CAP
- VINYL "T" POST

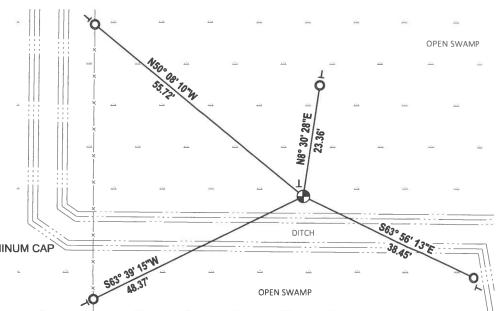

Government Land Corner Certificate 90 CORNER NO. _ ADAMS County **SECTION** TYPE OF MONUMENT: 2"x 6' IRON PIPE ALUM. CAP 16 TOWN STATE PLANE COORDINATES: N 43 50' 50.8 5 HAND HELD GPS F089°52'03.8" **RANGE** ELEVATION — M.S.L. DATUM: _ THETA ANGLE: ___ 76 FIELD BOOK: ____ PAGE . LANCE J. HABECK DRAWN BY: _____ BASIS FOR MONUMENT LOCATION Show info such as: History of corner, with reference to Vol. and pg., dates, surveyor; exact description of monument replaced; if location computed, by taped or EDM traverse; landowner remarks, etc. (Use reverse side if necessary) LOCATION (Indicated by 'X') SEAL: LANCE J. HABECK S-1444 Stevens Point, Wisa This corner was set equidistant and on a straight line between section corners. No evidence of the original corner or any resurvey corner was found. DATA SHOWN HERE ON CERTIFIED CORRECT: Registered Land DATE: TIE SKETCH Show at least four ties, also fence lines, roads, topo, size and type of witness trees' and if off road - best way to arrive at corner. FEW FENCE REMNANTS REMAINING MARSH ,00.50 500' + TO HIGH GROUND MARSH METAL Pas SIGN ON STEEL POST 0 DND SIGN MARSH

O - 14" x 4' WITNESS PIPE

MAINTENANCE RECORD

| DATE | BY WHOM | REMARKS |
|----------|------------|--|
| 11-4-85 | SOMENSEN | NOT ACCESSIBLE DUE TO HIGH WATER ASSUME O.K. FENCES VISIBLE FROM HIGH RINGE SW OF CORNER AT WOODS TRAIL SOO'T N.E. OF HOUSE. |
| 1-9-90 | <u> 55</u> | OK |
| 12-21-05 | JG | - OK |
| 12-21-05 | GR | 01< |
| | | |
| | | |
| l | | |
| | | |
| <u> </u> | | |
|] | | |
| | | |
| | | |