

PUBLIC LAND SURVEY MONUMENT RECORD

TYPE OF MONUMENT: HARRISON
 ADAMS COUNTY COORDINATES, NAD 83 (2007)

N. 175362.867
 E. 523172.132


ELEVATION- - - DATUM - -

FIELD WORK DATE: 02/02/2021

BASIS FOR MONUMENT LOCATION

1977 - PLS 1191 RESEARCHED COUNTY SURVEY NOTES. FOUND SURVEY MADE BY Z. WISE, OCT. 27, 1874, RECORDED IN VOL. 2, PG. 109. SET CORNER BY SINGLE PROPORTIONATE MEASURE FROM N1/4 CORNER. USED OCCUPATION LINE TO NORTH FOR DIRECTION EAST-WEST. THIS CORRELATED CLOSELY WITH EXISTING OCCUPATION AT THE SOUTHWEST CORNER OF SOUTHEAST1/4-SOUTHWEST1/4 AND THE CENTERLINE OF 14TH CT. AT THE SOUTHEAST CORNER SOUTHWEST1/4-SOUTHWEST1/4. EXCAVATED, BUT FOUND NO EVIDENCE OF BEARING TREES OR MONUMENTATION IN AREA. E.D.M. TRAVERSE. NOTE: PROPORTION DERIVED FROM MEASUREMENT ON NORTH LINE OF THE NORTHWEST1/4 OF SECTION 24 AND ABOVE SURVEY NOTES.

2021 - PLS 2675 FOUND A HARRISON MONUMENT FLUSH WITH THE GROUND AND DID NOT RECOVER ANY EXISTING TIES OR WITNESSES. ACCEPTED THE HARRISON AS THE CORNER LOCATION. SET 4 NEW TIES.

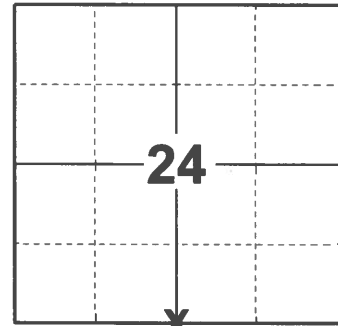

LOCATION

(INDICATE CORNER BY "X")

SEAL:




DATA SHOWN HERE ON THIS TIE SHEET IS CORRECT AND COMPLETE TO THE BEST OF MY KNOWLEDGE AND BELIEF.

PROFESSIONAL LAND SURVEYOR

DATE 3/3/2021

TIE SKETCH

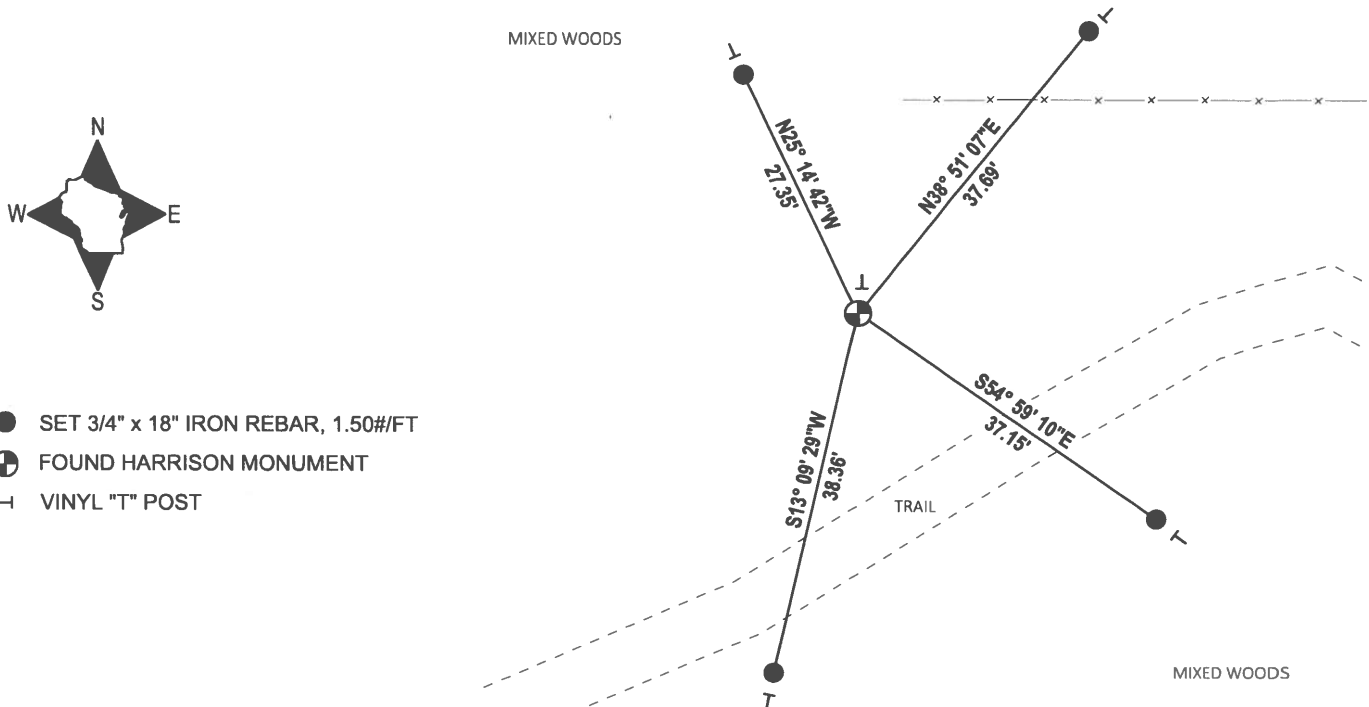

Government Land Corner Certificate

ADAMS County

TYPE OF MONUMENT: STANDARD HARRISON

STATE PLANE COORDINATES: N _____
E _____


ELEVATION — M.S.L. DATUM: _____

THETA ANGLE: _____

FIELD BOOK: 7701 PAGE 17

DRAWN BY: D. DONNELLY

CORNER NO. 92
SECTION 24
TOWN 16
RANGE 5

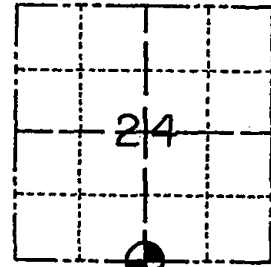

LOCATION
(Indicated by 'X')

BASIS FOR MONUMENT LOCATION

Show info such as: History of corner, with reference to Vol. and pg., dates, surveyor; exact description of monument replaced; if location computed, by taped or EDM traverse; landowner remarks, etc. (Use reverse side if necessary)

Researched County survey notes. Found survey made by Z. Wise, Oct. 27, 1874, recorded in Vol. 2, Pg. 109. Set corner by single proportionate measure from N $\frac{1}{4}$ cor. Used occupation line to north for direction east-west. This correlated closely with existing occupation at the S.W. Cor. of SE $\frac{1}{4}$ -SW $\frac{1}{4}$ and the centerline of 14th Ct. at the S.E. Cor. SW $\frac{1}{4}$ -SE $\frac{1}{4}$. Excavated, but found no evidence of bearing trees or monumentation in area. E.D.M. traverse.

SEAL:



Note:

Proportion derived from measurement on north line of the NW $\frac{1}{4}$ of section 24 and above survey notes.

DATA SHOWN HERE ON
CERTIFIED CORRECT:


Allen D. Rohde
Registered Land Surveyor

DATE: 12-12-77

TIE SKETCH

Show at least four ties, also fence lines, roads, topo, size and type of witness trees and if off road - best way to arrive at corner.

NOTE: MEASURED TO P.K. NAIL & SHINER IN BEARING TREES WITH BLAZES

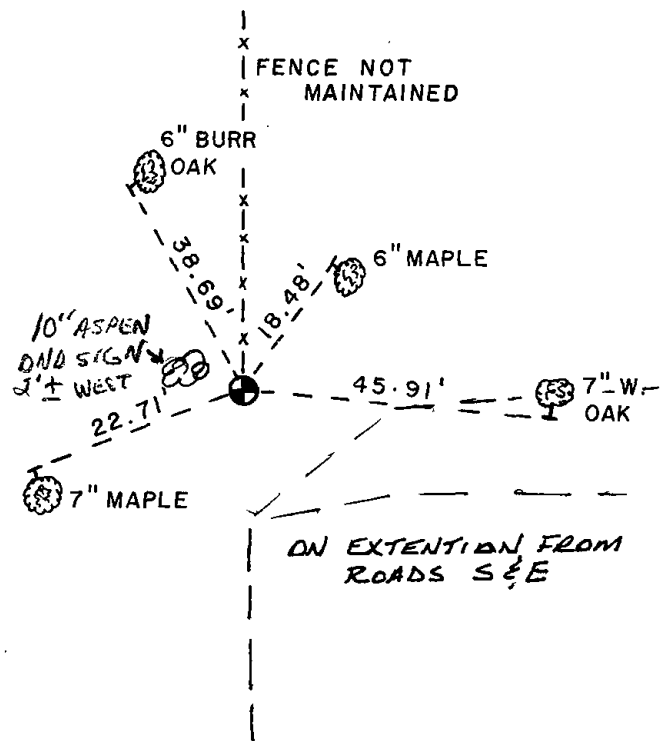

MAINTENANCE RECORD

Date	Init.	Remarks
10/13/80	KV-SK	COC. OK
2-14-85	GR-SS	OK
2-15-90	KZ-GR	OK
2-7-95	JG	OK
5-17-00	JG	OK
2-28-05	JG	OK
12-09-10	GR	OK