# OS ADAMS COUNTY COUNTY CORNER NO: 105

ROMPORTOL ID: 41605290000A

## PUBLIC LAND SURVEY MONUMENT RECORD

1-1/4" IRON ROD TYPE OF MONUMENT: ADAMS COUNTY COORDINATES, NAD 83 (2007) N. 170027.861 E. 504909.671 **ELEVATION-**DATUM FIELD WORK DATE: 02/18/2021

#### BASIS FOR MONUMENT LOCATION

1981 - PLS 1644 THIS MEANDER CORNER WAS SET ON THE SOUTH LINE OF SECTION 28 BY EXTENDING A STRAIGHT LINE FROM THE ST CORNER THROUGH A 1" IRON PIPE SET BY PERRY-CARRINGTON ENGINEERING, TO THE WATERS EDGE. THE SOUTHWEST CORNER OF SECTION 28 WAS ESTABLISHED BY FURTHER EXTENDING THIS LINE A DISTANCE OF 2643.30' FROM THE SOUTH QUARTER CORNER. THE DISTANCE GIVEN IN THE ORIGINAL NOTES FOR THIS LINE IS 2643.30'. IT WAS HELD BECAUSE STATIONING FOR A ROAD BEARING NORTHWESTERLY (NOW CTH 'Z') FITS THE PRESENT LOCATION OF CTH 'Z' FAIRLY ACCURATELY.

2021 - PLS 2675 FOUND 1-1/4" IRON ROD BY THE WATERS EDGE AND A IRON ROD. THE FOUND 1-1/4" IRON ROD IS ON A STRAIGHT LINE BETWEEN THE S1/4 AND FOUND IRON ROD. ACCEPTED THE 1-1/4" IRON ROD AS THE MEANDER CORNER. SET 2 NEW TIES, MEASURED TO A FOUND RIGHT-OF-WAY IRON AND THE S1/4 OF SECTION 28.



(INDICATE CORNER BY "X")




DATA SHOWN HERE ON THIS TIE SHEET IS CORRECT AND COMPLETE TO THE BEST OF MY KNOWLEDGE AND BELIEF.

PROFESSIONAL LAND SURVEYOR 2021 DATE

-TIE SKETCH



- SET 3/4" x 18" IRON REBAR, 1.50#/FT
- O FOUND 3/4" IRON ROD
- FOUND 1-1/4" IRON ROD MONUMENT
- STEEL FENCE POST
- VINYL "T" POST

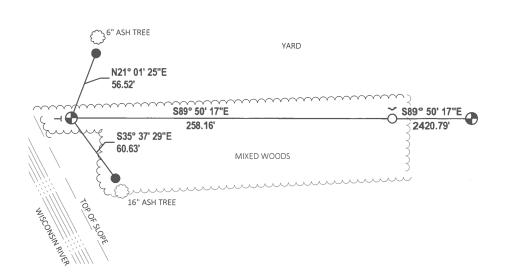

## Government Land Corner Certificate

A	DAMS	C	our	ntv	
TYPE OF MONUME	NT: <u>2"x 30</u>	" IRON P	PE/	ALUM. CA	P
STATE PLANE COO			-		
		F			
ELEVATION — M.	S.L. DATUM	:			
THETA ANGLE: _					
FIELD BOOK:	76	PA	GE _	36	
DRAWN BY:	LANCE	J. HABE	CK		


### BASIS FOR MONUMENT LOCATION

Show info such as: History of corner, with reference to Vol. and pg., dates, surveyor; exact description of monument replaced; if location computed, by taped or EDM traverse; landowner remarks, etc. (Use reverse side if necessary)

This meander corner was set on the south line of Section 28 by extending a straight line from the  $S_{4}^{\frac{1}{4}}$  corner through a 1" iron pipe set by Perry-Carrington Eng. in the waters edge. The southwest corner of Section 28 was established by further extending this line adistance of 2643.30' from the south quarter corner. The distance given in the original notes for this line is 2643.30'. It was held because stationing for a road bearing northwesterly (now CTH "Z") fitsthbegaresent location of CTH "Z" fairly accurately.

ALL OK 4/15/85 D.K. ALL OK 2-15-90 KZ-GR SEE CSM# 4675 (MSA)

105 CORNER NO. \_\_\_ SECTION 16 TOWN 5

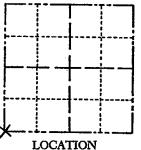

RANGE



(Indicated by 'X')

SEAL: SHEED SECONS LANCE J. HABECK Stevens Point,

DATA SHOWN HERE ON CERTIFIED CORRECT:

DATE:

### TIE SKETCH

Show at least four ties, also fence lines, roads, topo, size and type of witness trees' and if off road - best way to arrive at corner.

BURR OAK "IRON PIPE FOUND SECTION CORNER CLUSTER (BT)

## MAINTENANCE RECORD

DATE	BY WHOM	REMARKS
2-15-90	KZ-GR	ALL OK GONE
2-16-90	KZ-GR T.W. S.S.	GONE
		·
<u> </u>		
-		
i		