16 TOWN

ADAMS COUNTY COUNTY COUNTY CORNER NO: 107

ROMPORTOL ID: 41605280000

PUBLIC LAND SURVEY MONUMENT RECORD

HARRISON (BROKEN-TOP) TYPE OF MONUMENT: ADAMS COUNTY COORDINATES, NAD 83 (2007) N. 170004.359 E. 509990.545 DATUM_ 02/17/2021 FIELD WORK DATE:


BASIS FOR MONUMENT LOCATION

1977 - PLS 878 DUB WITH BACKHOE AND FOUND STAIN OF DUG IN POST. MONUMENT SAME WITH HARRISON. LOCATION VERIFIED BY EDM TRAVERSE.

2021 - PLS 2675 FOUND HARRISON (BROKEN-TOP) 6"± BELOW THE ROAD SURFACE AND 1 WITNESS. THE MONUMENT AGREES WITH THE EXISTING WITNESS. ACCEPTED THE HARRISON (BROKEN-TOP) AS THE CORNER LOCATION. SET 4 NEW TIES AND MEASURED TO THE EXISTING WITNESS.



(INDICATE CORNER BY "X")

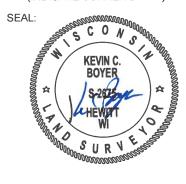


DATA SHOWN HERE ON THIS TIE SHEET IS CORRECT AND COMPLETE TO THE BEST OF MY KNOWLEDGE AND BELIEF.

PROFESSIONAL LAND SURVEYOR 1505

-TIE SKETCH

NOTE: THE CORNER LANDS 4'± SOUTH OF EVERGREEN AVE. CENTERLINE.



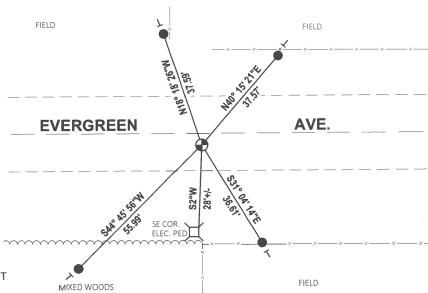

- SET 3/4" x 18" IRON REBAR, 1.50#/FT
 - FOUND HARRISON (BROKEN-TOP) MONUMENT
- VINYL "T" POST

Government Land Corner Certificate

ADAMS (County
TYPE OF MONUMENT: HARRISON	\$70.
STATE PLANE COORDINATES: N	
<u> </u>	
ELEVATION — M.S.L. DATUM:	· .
THETA ANGLE:	
FIELD BOOK: 54 (651) PA	AGE 80 (14)
DRAWN BY: Scott SORENSEN	

BASIS FOR MONUMENT LOCATION

Show info such as: History of corner, with reference to Vol. and pg., dates, surveyor; exact description of monument replaced; if location computed, by taped or EDM traverse; landowner remarks, etc. (Use reverse side if necessary)


ABK dug with backhoe and found stain of dug in post Monumented same with Harrison. Logation verified by EDM traverse-



CORNER NO.

SECTION TOWN

SEAL:

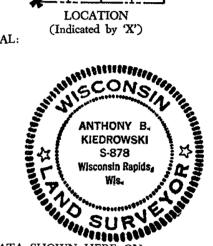

DATA SHOWN HERE ON CERTIFIED CORRECT:

Registered Land Surveyor

DATE: <u>11/1/77</u>

TIE SKETCH

Show at least four ties, also fence lines, roads, topo, size and type of witness trees' and if off road - best way to arrive at corner.

MAINTENANCE RECORD

MAINTENANCE RECORD		
Date	Init.	Remarks
10/3/80	KU-SK	MON. BROKEN-RETIED
4/15/85	DK	TOP BROKEN
2-15-90	KZ-GR	ALL OK
2-7-95	J 6	ALL OK
2-10-00		ALL OK
3-4-05	کت کک	ALL OK
77-10	55	3 NEW
REVISED 1977		

Q EVERGREEN GONE B"BIK, W SE COK BEC OCKD of BEC SP62" F 10" JACK PINE DEAD 10