O5 RANGE ADAMS COUNTY CORNER NO: 110 ROMPORTOL ID: 41605260020


PUBLIC LAND SURVEY MONUMENT RECORD

HARRISON TYPE OF MONUMENT: ADAMS COUNTY COORDINATES, NAD 83 (2007) N. **170007.935** E. 517930.798 __ DATUM_ ELEVATION-02/15/2021 FIELD WORK DATE:___

BASIS FOR MONUMENT LOCATION

1978 - PLS 878 SET EQUIDISTANT AND ON LINE BETWEEN ADJACENT SECTION CORNERS. NO EVIDENCE OF ANY PREVIOUS MONUMENTATION WAS FOUND.

2021 - PLS 2675 FOUND HARRISON FLUSH WITH THE GROUND AND 1 WITNESS. THE MONUMENT AGREES WITH THE WITNESS AND IS ON A STRIGHT LINE AND EQUIDISTANT SPLIT BETWEEN THE SE AND SW CORNERS OF SECTION 26. ACCEPTED THE HARRISON AS THE CORNER LOCATION. SET 4 NEW TIES AND MEASURED TO THE EXISTING WITNESS.

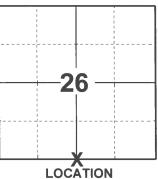

(INDICATE CORNER BY "X")




DATA SHOWN HERE ON THIS TIE SHEET IS CORRECT AND COMPLETE TO THE BEST OF MY KNOWLEDGE AND BELIEF.

PROFESSIONAL LAND SURVEYOR 202

- TIE SKETCH



- SET 3/4" x 18" IRON REBAR, 1.50#/FT
- FOUND HARRISON MONUMENT
- VINYL "T" POST
- MITNESS STUMP

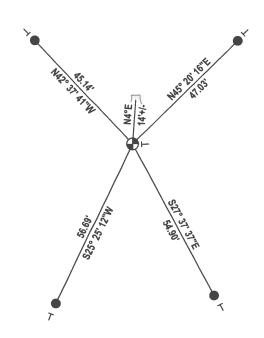

Government Land Corner Certificate

ADAMS County
TYPE OF MONUMENT: HARRISON MAC NAIL
STATE PLANE COORDINATES: N
<u>E</u>
ELEVATION — M.S.L. DATUM:
THETA ANGLE:
FIELD BOOK:
DRAWN BY: B. MERZ
DRAWN BI:

CORNER NO. SECTION TOWN **RANGE**

LOCATION

(Indicated by 'X')

BASIS FOR MONUMENT LOCATION

Show info such as: History of corner, with reference to Vol. and pg., dates, surveyor; exact description of monument replaced; if location computed, by taped or EDM traverse; landowner remarks, etc. (Use reverse side if necessary)

Set equidistant and on line between adjacent section corners.

No evidence of any previous monumentation was found,

SEAL:

DATA SHOWN HERE ON CERTIFIED CORRECT:

Registered Land Shrveyor

TIE SKETCH

Show at least four ties, also fence lines, roads, topo, size and type of witness trees' and if off road - best way to arrive at corner.

W0005

12" TWIN BLACKDAK DND SIGN ON TWIN 10" JACK PINE SAND

6" BIRCH

MAINTENANCE RECORD

Date	Init.	Remarks
10/13/80	KUKK	COK. OK
3-23-90	Kz-55	ALLOK
2-7-95	J6	ALL OK
12-01-00	575	n 4
1-13-05	76-DA	√1
12-20-10	55	11 11