TOWN

# ADAMS COUNTY COUNTY CORNER NO: 111 ROMPORTOL ID: 41605260000

## PUBLIC LAND SURVEY MONUMENT RECORD

**3/4" IRON ROD** TYPE OF MONUMENT: ADAMS COUNTY COORDINATES, NAD 83 (2007) N. 170018.849 F 520572.966 ELEVATION-DATUM 02/11/2021 FIELD WORK DATE:

#### BASIS FOR MONUMENT LOCATION

1978 - PLS 878 FOUND 3/4" IRON ROD SET BY DAVID CLARK IN MY OF 1972. THIS BAR HAS BEEN USED FOR SURVEYS IN SECTIONS 26 & 35, 16-5. THE BAR WAS ACCEPTED AS THE CORNER, THE CORNER FALLS IMMEDIATELY ADJACENT TO AN EXISTING FENCE CORNER MAKING IT IMPOSSIBLE TO SET A HARRISON MONUMENT.

2021 - PLS 2675 FOUND 3/4" IRON ROD FLUSH WITH THE GROUND AND 3 WITNESSES. THE MONUMENT AGREES WITH ALL THE WITNESSES. ACCEPTED THE 3/4" IRON ROD AS THE CORNER LOCATION. SET 4 NEW TIES AND MEASURED TO THE EXISTING WITNESSES.



(INDICATE CORNER BY "X")




DATA SHOWN HERE ON THIS TIE SHEET IS CORRECT AND COMPLETE TO THE BEST OF MY KNOWLEDGE AND BELIEF.

PROFESSIONAL LAND SURVEYOR 2021

#### -TIE SKETCH



- SET 3/4" x 18" IRON REBAR, 1.50#/FT
- FOUND 3/4" IRON ROD MONUMENT
  - STEEL FENCE POST
- VINYL "T" POST
- WITNESS TREE

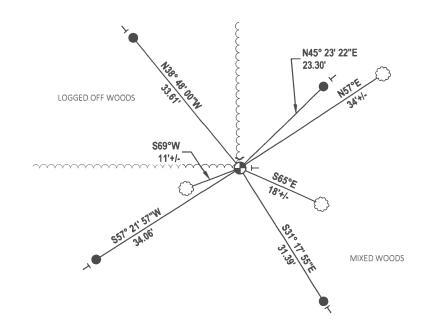

## Government Land Corner Certificate


ADAMS_County	
TYPE OF MONUMENT: 1/2" REBAR	
STATE PLANE COORDINATES: N	
<u> E</u>	
ELEVATION — M.S.L. DATUM:	<del></del>
THETA ANGLE:	
FIELD BOOK: 57 PAGE 72	<del></del>
DRAWN BY: B. MERZ	<del></del> .

## BASIS FOR MONUMENT LOCATION

Show info such as: History of corner, with reference to Vol. and pg., dates, surveyor; exact description of monument replaced; if location computed, by taped or EDM traverse; landowner remarks, etc. (Use reverse side if necessary)

Found 3/4 iron rod set by David Clarkkin May of 1972. This bar has been used for surveys in Sections 26 & 35 16-5.

The bar was accepted as the corner.
The corner falls immeadiatly adjacent to an existing fence corner making it impossible to set a harrison monument.

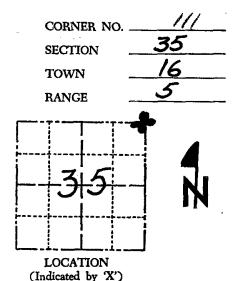

SEAL:



DATA SHOWN HERE ON CERTIFIED CORRECT:

Registered Land Surveyor

DATE: 8-1-78

### TIE SKETCH

Show at least four ties, also fence lines, roads, topo, size and type of witness trees' and if off road - best way to arrive at corner.

#### MAINTENANCE RECORD

Date	Init.	Remarks
10/4/80	KU-SK	COR OK
2-15-90	KZ-GR	OK
2-7-95	IG	OK
12-61-80	55	,,
12-21-05	50	•
12-20-10	55	2 NEW TIE

