# 05 ADAMS COUNTY CORNER NO: 112 ROMPORTOL ID: 41605250020

## PUBLIC LAND SURVEY MONUMENT RECORD

**HARRISON** TYPE OF MONUMENT: ADAMS COUNTY COORDINATES, NAD 83 (2007) N. 170024.604 E. 523226.593 **ELEVATION-**DATUM\_ 02/15/2021 FIELD WORK DATE:

### **BASIS FOR MONUMENT LOCATION**

1982 - PLS 1644 EXCAVATED WITH BACKHOE, FOUND 7"X7"X21" PERFECTLY SQUARE SANDSTONE. LOWERED STONE AND SET HARRISON ON TOP.

2021 - PLS 2675 FOUND HARRISON 3"± BELOW THE GROUND, 1 TIE, AND 1 WITNESS. THE MONUMENT AGREES WITH THE EXISTING TIE AND WITNESS. ACCEPTED THE HARRISON AS THE CORNER LOCATION. SET 3 NEW TIES AND MEASURED TO THE EXISTING TIE AND WITNESS.



(INDICATE CORNER BY "X")




DATA SHOWN HERE ON THIS TIE SHEET IS CORRECT AND COMPLETE TO THE BEST OF MY KNOWLEDGE AND BELIEF.

PROFESSIONAL LAND SURVEYOR

#### -TIE SKETCH



- SET 3/4" x 18" IRON REBAR, 1.50#/FT
- FOUND 3/4" IRON ROD
- FOUND HARRISON MONUMENT
- VINYL "T" POST
- WITNESS TREE

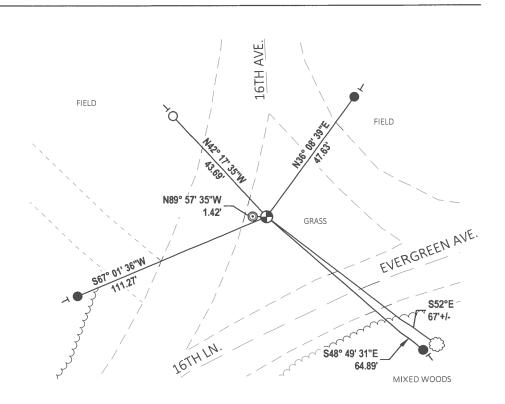

Government Land Corner Certificate	
ADAMS County	CORNER NO. //2
TYPE OF MONUMENT: HARRISON	SECTION
STATE PLANE COORDINATES: N	TOWN
ELEVATION — M.S.L. DATUM: THETA ANGLE:	RANGE
FIELD BOOK: 92 PAGE 47  DRAWN BY: LANCE HABECK	
BASIS FOR MONUMENT LOCATION	
Show info such as: History of corner, with reference to Vol. and pg., dates, surveyor; exact description of monument replaced; if location computed, by taped or EDM traverse; landowner remarks, etc. (Use reverse side if necessary)	LOCATION (Indicated by 'X')
Excavated with backhoe, found 7%x7%x21" perfectly square sandstone. Lowered stone and set Harrison on top.	
ALL OK 2/14/85 GR-SS	LANCE J. HABECK S-1444 Stevens Point,
r	Wisa Wisa SUR WILLIAM
	Manual Comment
	DATA SHOWN HERE ON CERTIFIED CORRECT:
	Registered Land Surveyor
	DATE: <u>5/3/82</u>
TIE SKETCH	· · · · · · · · · · · · · · · · · · ·
Show at least four ties, also fence lines, roads, topo, size and type of witness trees' and if off road - best way to arrive at corner.	·
SET 3/4" X 18" GONE  RED 44.0' 1"HON PIPE!  EN 40° IN PLASTIC PIUG  EN 40° IN PLASTIC PIUG	NEW POWER POLE
	AVE.
115±	£
10" SACK PINE (BT)  EVERGREEN	(3) 13" BURR OAK (BT)
EVERGI	

## MAINTENANCE RECORD

DATE	BY WHOM	REMARKS
2-15-90	KZ-GR	ALL OK
8-25-94	JG-BS	ALL OK
5-17-00	JG	2-GONE, 2-NEW, MON. OK
12/21/05	J6 J6	0K
7-7-10	55	1 NOW TE - OK
Ç		
£\$0.		
\$17.5	<u> </u>	