O5 RANGE ADAMS COUNTY COUNTY CORNER NO: 118 ROMPORTOL ID: 41605342000


PUBLIC LAND SURVEY MONUMENT RECORD

SURVEY NAIL TYPE OF MONUMENT: ADAMS COUNTY COORDINATES, NAD 83 (2007) N. **167352.418** E. 515273.823 DATUM_ ELEVATION-02/24/2021 FIELD WORK DATE:

BASIS FOR MONUMENT LOCATION

1976 - PLS 1103 RAN TRAVERSE (EDM/T2) AROUND SOUTH HALF OF SECTION 35 TO DETERMINE SEARCH AREAS. FOUND 16" END OF BUGGY AXLE LOCATION SHOWN ON SKETCH. ACCEPTED AS CORNER THOUGH NO RECORD OF AXLE OR EXISTING WITNESS MONUMENTS WERE FOUND. REPLACED WITH HARRISON MONUMENT.

2021 - PLS 2675 FOUND PK NAIL IN THE ROAD SURFACE, REMOVED AND FOUND NO OTHER MONUMENTS BELOW. THE CORNER AGREES WITH SECTION SUMMARY DISTANCES FROM THE NE TO E1/4 AND SE TO THE E1/4. ACCEPTED THE PK NAIL LOCATION FOR THE CORNER. SET A SURVEY NAIL IN THE PK NAIL LOCATION AND SET 4 NEW TIES.

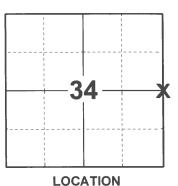

(INDICATE CORNER BY "X")




DATA SHOWN HERE ON THIS TIE SHEET IS CORRECT AND COMPLETE TO THE BEST OF MY KNOWLEDGE AND BELIEF.

PROFESSIONAL LAND SURVEYOR

-TIE SKETCH

NOTE: THE CORNER LANDS 1'± SOUTH OF CTH 'H' CENTERLINE AND 1'± EAST OF 16TH AVE. CENTERLINE.



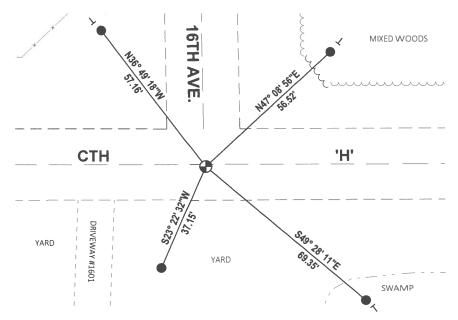

- SET 3/4" x 18" IRON REBAR, 1.50#/FT
- SET SURVEY NAIL MONUMENT
- VINYL "T" POST

CORNER NO. ADAMS COUNTY SECTION Survey Monument Record MAG NAIL TOWN TYPE OF MONUMENT: 30" HARRISON MONUMENT RANGE STATE PLANE COORDINATES: N E ELEVATION - M.S.L. DATUM: _ THETA ANGLE: ____ FIELD BOOK: ___ BASIS FOR MONUMENT LOCATION (Use reverse side if necessary) Show info such as: History of corner, with reference to Vol. and pg, dates, surveyor; exact description of monument replaced; if location computed, by taped or EDM traverse; landowner LOCATION SEAL: remarks, etc. Ran traverse(EDM/T2) around South Half of Section 35 to determine search areas. Found 14" end of buggy axel at location shown on sketch. Accepted as corner though no record of axel or existing witness monuments was found. Replaced with Harrison Monument. COR OK 10/6/80 KU-SK ALL OK 4/15/85 D.K. ALL OK CERTIFIED CORRECT: 2-15-90 KZ-GR 1-NEW 2-7-95-JG ALL OK 2-10-00 T.W.SS. Registered Land Survey GONE 2NEW 3-4-05 55 JS DATE: __ Sept TIE SKETCH 10" (Show at least four ties) CEDAK GONE ID" BURR OAK BT EXISTING 5" CONCRETE 1choss Ties in trees to nail in disc. LARGE CORNER POST

COR. GARAGE #1601 NEW 03

POWER