SECTION

OF ADAMS COUNTY

COUNTY CORNER NO: 132

ROMPORTOL ID: 41605360020


PUBLIC LAND SURVEY MONUMENT RECORD

HARRISON TYPE OF MONUMENT: ADAMS COUNTY COORDINATES, NAD 83 (2007) N. **164735.677** E. 523215.836 DATUM — — FIELD WORK DATE: 10/10/2017


BASIS FOR MONUMENT LOCATION

1976 - PLS 878 EXCAVATED AT THE CORNER WITH A BACKHOE AND FOUND NOTHING. THE AREA FALLS IN A ROAD CUT. SET A HARRISON MONUMENT ON A STRAIGHT LINE AND HALF WAY BETWEEN CONCRETE REFERENCE MONUMENTS WHICH WERE 66' APART AND TIED

2017 - PLS 2994 FOUND A HARRISON MONUMENT 2" BELOW THE ROAD SURFACE AND 2 TIES. THE MONUMENT AGREES WITH THE EXISTING TIES. ACCEPTED THE HARRISON MONUMENT AS THE CORNER LOCATION. SET 2 NEW TIES AND MEASURED TO THE TIES.

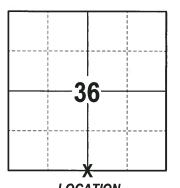

LOCATION (INDICATE CORNER BY "X")

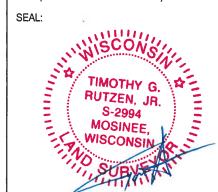

DATA SHOWN HERE ON THIS TIE SHEET IS CORRECT AND COMPLETE TO THE BEST OF MY KNOWLEDGE AND BELIEF.

PROFESSIONAL LAND SURVEYOR


12-4-17 DATE

- TIE SKETCH

NOTE: THE CORNER FALLS 7'± SOUTH OF THE CENTERLINE OF FAWN AVE.



- 3/4" x 18" IRON REBAR SET, 1.50#/FT ○ 3/4" O.D. IROD PIPE FOUND ⊕ 4" CONCRETE MONUMENT FOUND
- HARRISON FOUND ✓ STEEL FENCE POST → VINYL "T" POST

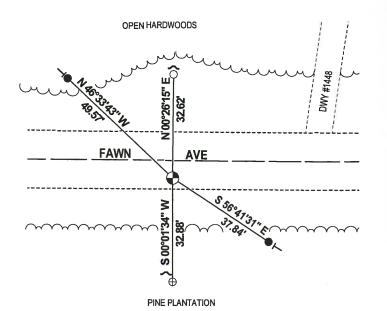

ADAMS COUNTY

Survey Monument Record

TYPE OF MONUMENT: Harrison standard STATE PLANE COORDINATES: N_

ELEVATION - M.S.L. DATUM:

THETA ANGLE: .

FIELD BOOK: _file PAGE _



SECTION

TOWN

RANGE

16

5

BASIS FOR MONUMENT LOCATION

(Use reverse side if necessary)

Show info such as: History of corner, with reference to Vol. and pg, dates, surveyor; exact description of monument replaced; if location computed, by taped or EDM traverse; landowner remarks, etc.

Excavated with backhoe. Found nothing. Area falls in road cut. Corner set on a straight line and half way between concrete reference monuments which were 66' apart.

COR. OK 10/6/80 KU-SK

COR OK 7-9-85

OK 2-15-90 KZ-GR

1-GONE 1-NEW 8-25-94 JG-BS

ALL OK 5-17-00 TG

AM AM S-878 Wisconsin Rapids

CERTIFIED CORRECT:

SEAL:

Acotron of Kes class
Registered Land Surveyor DATE: 8/26/76

TIE SKETCH

(Show at least four ties)

GONE 94 Concrete Witness L" BLKOAH JOHOE FOUND OK

LOGGED

AFF CONCRETE MON. U

