33 SECTION

17 TOWN

OB ADAMS COUNTY

COUNTY CORNER NO: 127

ROMPORTOL ID: 41706330000


PUBLIC LAND SURVEY MONUMENT RECORD

HARRISON TYPE OF MONUMENT: ADAMS COUNTY COORDINATES, NAD 83 (2007) N. 192408.782 E. 541794.630 DATUM 11/27/2017 FIELD WORK DATE:


BASIS FOR MONUMENT LOCATION

1972 - PLS 878 LOCATION WAS DETERMINED BY TRAVERSING THE ENTIRE SECTION AND COMPARING POSSESSION LINES AND ORIGINAL GOVERNMENT NOTES. THE CORNER WAS PREVIOUSLY MARKED WITH A PK NAIL. REPLACED THE PK NAIL WITH A HARRISON MONUMENT AND RE-TIED.

2017 - PLS 2994 FOUND A MAG NAIL IN THE ROAD SURFACE REMOVED THE MAG NAIL AND FOUND A HARRISON MONUMENT 6" BELOW THE MAG NAIL. NO WITNESSES WERE FOUND OTHER THAN 1 PROPERTY IRON. ACCEPTED THE HARRISON MONUMENT AS THE CORNER LOCATION, SET 3 NEW TIES AND MEASURED TO THE TIES AND PROPERTY IRON.

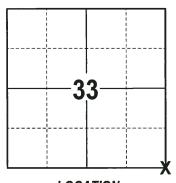

LOCATION (INDICATE CORNER BY "X")

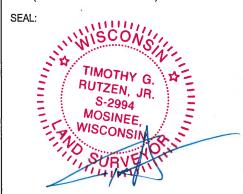

DATA SHOWN HERE ON THIS TIE SHEET IS CORRECT AND COMPLETE TO THE BEST OF MY KNOWLEDGE AND BELIEF.

PROFESSIONAL LAND SURVEYOR


12-21-17

- TIE SKETCH

NOTE: THE CORNER FALLS 2'± EAST OF THE CENTERLINE OF 10TH AVE.



 3/4" x 18" IRON REBAR SET, 1.50#/FT ⊕ 1-1/4" IROD ROD FOUND HARRISON FOUND → VINYL "T" POST

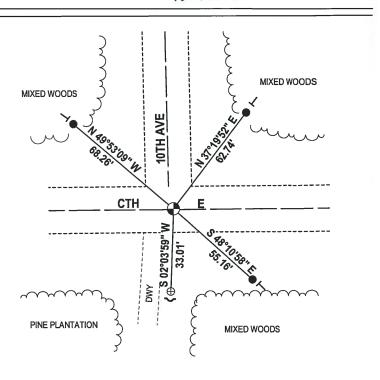

CORNER NO. __/86 ADAMS COUNTY SECTION Survey Monument Record TOWN TYPE OF MONUMENT: HARRISON MONUMENT RANGE STATE PLANE COORDINATES: N. E ELEVATION - M.S.L. DATUM: _ THETA ANGLE: . FIELD BOOK: 105 PAGE _67 BASIS FOR MONUMENT LOCATION (Use reverse side if necessary) LOCATION Show info such as: History of corner, with reference to Vol. and pg, dates, surveyor; exact description of monument replaced; if location computed, by taped or EDM traverse; landowner (Indicated by 'X') ANTHONY B. MEDROWSKI S-878 Wisconsin Rapids. Wis. SEAL: remarks, etc. Location was determined by traverseing September 5, 1972 Anthony B. Kiedrowski R.L.S. 878 Location determined by traversing entire section and comparing posession lines and original government notes. Point monumented was previously marked with a PK nail. CERTIFIED CORRECT: COR. OK. 10-2-75 55 COR OK 10/15/80 KV-RN ALL OK 7/15/85 ALL OK 1-30-90 DATE: ALL OK 2/2/95-06 ALL OK 2/15/00 JG-55 ALL OK, 2-22-05 TIE SKETCH (Show at least four ties) STUMP ' NAIL & WASHER 14"Benck NAIL &WASHER IN OAK €.T.H. "E DNAIL & WASHER POWER POLE

NAIL EWASHER

IN OAK 10' BLACK