34 SECTION

TOWN

OB ADAMS COUNTY

COUNTY CORNER NO: 128

ROMPORTOL ID: 41706340020


PUBLIC LAND SURVEY MONUMENT RECORD

HARRISON TYPE OF MONUMENT: ADAMS COUNTY COORDINATES, NAD 83 (2007) N. **192425.011** E. 544430.363 DATUM — — 11/27/2017 FIELD WORK DATE:


BASIS FOR MONUMENT LOCATION

1972 - PLS 878 FOUND RR SPIKE AND ACCEPTED AS CORRECT AFTER TRAVERSING THE ENTIRE SECTION. THIS POINT IS ON A STRAIGHT LINE EQUIDISTANT BETWEEN SECTION CORNERS. REPLACED THE RR SPIKE WITH A HARRISON MONUMENT AND RE-TIED.

2017 - PLS 2994 FOUND A HARRISON MONUMENT 6" BELOW THE ROAD SURFACE, CONFIRMED THE CORNER LOCATION BY VERIFYING IF IT WAS ON A STRAIGHT LINE AND EQUIDISTANT BETWEEN THE SW AND SE CORNERS OF SECTION 34. ACCEPTED THE HARRISON MONUMENT AS THE CORNER LOCATION. SET 4 NEW TIES AND MEASURED TO THE TIES.

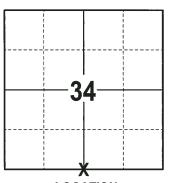

LOCATION (INDICATE CORNER BY "X")

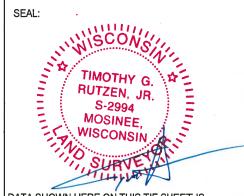

DATA SHOWN HERE ON THIS TIE SHEET IS CORRECT AND COMPLETE TO THE BEST OF MY KNOWLEDGE AND BELIEF.

PROFESSIONAL LAND SURVEYOR


DATE /2-21-17

- TIE SKETCH

NOTE: THE CORNER FALLS 1.5'± NORTH OF THE CENTERLINE OF CTH E AND 10' EAST OF 9TH DR TO THE NORTH.



- 3/4" x 18" IRON REBAR SET, 1.50#/FT BRASS DISK IN CONCRETE (NGS 3U11)
- HARRISON FOUND → VINYL "T" POST

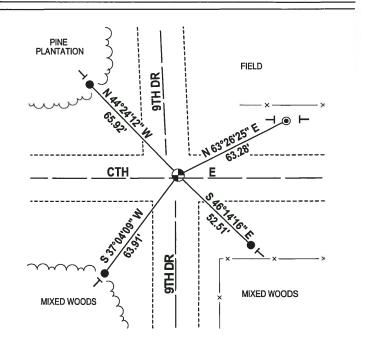

187 ADAMS COUNTY CORNER NO. _ SECTION Survey Monument Record TOWN TYPE OF MONUMENT: HARRISON MONUMENT RANGE STATE PLANE COORDINATES: N. F ELEVATION - M.S.L. DATUM: . THETA ANGLE: . FIELD BOOK: __105 _ page <u>__**6**8</u> BASIS FOR MONUMENT LOCATION (Use reverse side if necessary) Show info such as: History of corner, with reference to Vol. and pg, dates, surveyor; exact description of monument replaced; if location computed, by taped or EDM traverse; landowner LOCATION SEAL: remarks, etc. Found R.R. spike and set monument September 5, 1972 Anthony B. Kiedrowski R.L.S. 878 RR spike accepted as correct after traversing entire section. This point is on a straight line equidistant between section corners. HARRISON O.t. 10.2.25 CERTIFIED CORRECT COR OK 10/15/80 KU-RN ALL OK 7/15/85 Registered Land Surveyor DATE: 1 - 30 -ALL OK 1-30-90 GR ALL OK 2-22-05- JG 1 NEW 1-12-10 55 2/2/9556 TIE SKETCH ALL JG-55 (Show at least four ties) NAIL & WASHER IN OAK O . ه. جو 40"86405 10" BURR OAK/BT a't NAIL & WASHER IN POWER POLE