FIELD WORK DATE:

# OB ADAMS COUNTY

COUNTY CORNER NO: 129

ROMPORTOL ID: 41706340000

## PUBLIC LAND SURVEY MONUMENT RECORD


TYPE OF MONUMENT: **HARRISON** ADAMS COUNTY COORDINATES, NAD 83 (2007) N. **192441.289** E. 547065.712 DATUM --**ELEVATION-**

011/21/2017


#### BASIS FOR MONUMENT LOCATION

1972 - PLS 878 LOCATION DETERMINED BY TRAVERSING THE ENTIRE SECTION AND COMPARING GOVERNMENT NOTES AND POSSESSION LINES. SET A HARRISON MONUMENT AT THE CALCULATED LOCATION AND TIED OUT.

2017 - PLS 2994 FOUND A HARRISON MONUMENT 6" BELOW THE ROAD SURFACE, NO WITNESSES WERE RECOVERED. ACCEPTED THE HARRISON MONUMENT AS THE CORNER LOCATION, SET 4 TIES AND MEASURED TO THE TIES.

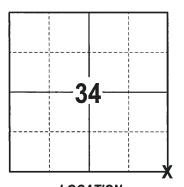

LOCATION (INDICATE CORNER BY "X")

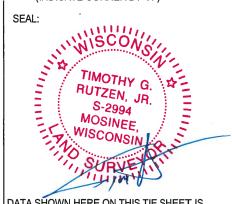


DATA SHOWN HERE ON THIS TIE SHEET IS CORRECT AND COMPLETE TO THE BEST OF MY KNOWLEDGE AND BELIEF.

PROFESSIONAL LAND SURVEYOR

#### - TIE SKETCH

NOTE: THE CORNER FALLS 2'± NORTH OF THE CTH E CENTERLINE AND 12' WEST OF THE CENTERLINE OF 9TH AVE.



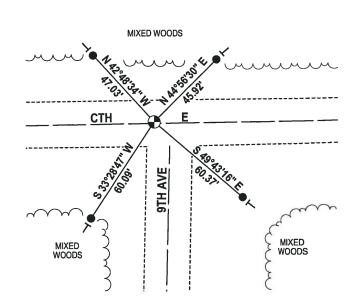

 3/4" x 18" IRON REBAR SET, 1.50#/FT HARRISON FOUND

→ VINYL "T" POST

### ADAMS COUNTY CORNER NO. \_\_\_ SECTION Survey Monument Record TOWN TYPE OF MONUMENT: \_HARRISON MONUMENT RANGE STATE PLANE COORDINATES: N\_ $\mathbf{E}$ ELEVATION - M.S.L. DATUM: \_ THETA ANGLE: \_ 105 FIELD BOOK: \_\_\_\_ PAGE \_ BASIS FOR MONUMENT LOCATION (Use reverse side if necessary) LOCATION Show info such as: History of corner, with reference to Vol. and pg, dates, surveyor; exact description of monument replaced; if location computed, by taped or EDM traverse; landowner (Indicated by 'X') SEAL: ANTHONY B. KIEDROWSKI S-878 Wisconsin Rapids, Wis. remarks, etc. Location was determined by traverseing August 4. 1972 Anthony B. Kiedrowski R.L.S. 878 Location determined by traversing entire section and comparing government notes and posession lines. Horrison O.K. - need I new CERTIFIED CORRECT 2.7.3 COR OK 10/15/80 KU-RA Registered Land Surveyor 7/15/85 DATE: 1-30-1-30-90 GR ALL OK

