

ADAMS

JUNEAU COUNTY

Survey Monument Record

TYPE OF MONUMENT: HARRISON

STATE PLANE COORDINATES: N _____

E _____

ELEVATION — M.S.L. DATUM: _____

THETA ANGLE: _____


FIELD BOOK: _____ PAGE _____

CORNER NO. 22

SECTION 7


TOWN 16 N

RANGE 16 E

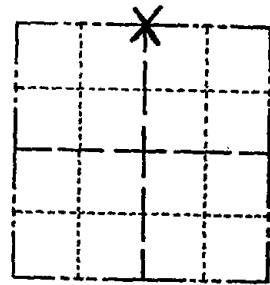

LOCATION
(Indicated by 'X')

SEAL:

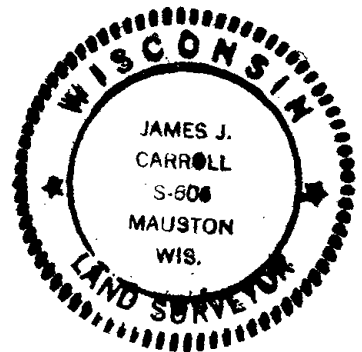

BASIS FOR MONUMENT LOCATION

(Use reverse side if necessary)

Show info such as: History of corner, with reference to Vol. and pg, dates, surveyor; exact description of monument replaced; if location computed, by taped or EDM traverse; landowner remarks, etc.

Due to the conflicting information in regard to the old Adams county records for this area an extensive field search was made in this area. I found a 4"x30" Tamarack post chiseled pointed with old wire running easterly and southerly therefrom. Accepted this location as the true corner location.

All O.K. 10-28-85 SS

ALL OK 1-11-90 SS.

1-NEW 2-2-95 JG-GR

2-DEAD 2-15-91, 5-17-00-JG

ALL OK 4-8-05 JG

1 NEW TIE JAN 2010

CERTIFIED CORRECT

James J. Carroll
Registered Land Surveyor

DATE: Oct. 17, 1981

TIE SKETCH

(Show at least four ties)

NOTE: CORNER IS 1,000' ± EAST OF 13TH PR.

