


# Government Land Corner Certificate

ADAMS County *SET 3/4" ROD 10-31-85*  
 TYPE OF MONUMENT:  $\frac{1}{2}$ " X 12" Rebar to be replaced in spring.  
 STATE PLANE COORDINATES: N \_\_\_\_\_  
 E \_\_\_\_\_  
 ELEVATION — M.S.L. DATUM: \_\_\_\_\_  
 THETA ANGLE: \_\_\_\_\_  
 FIELD BOOK: A-F 3 PAGE 20  
 DRAWN BY: S. Sorensen

CORNER NO. 26  
 SECTION 9  
 TOWN 16  
 RANGE 6

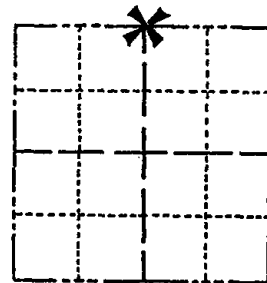


LOCATION  
(Indicated by 'X')

## BASIS FOR MONUMENT LOCATION

Show info such as: History of corner, with reference to Vol. and pg., dates, surveyor; exact description of monument replaced; if location computed, by taped or EDM traverse; landowner remarks, etc. (Use reverse side if necessary)

Set corner equidistant and on line between adjacent section corners. No evidence of any previous monumentation could be found, as the area surrounding the corner had been recently cleared and dozed for farming.

SEAL:

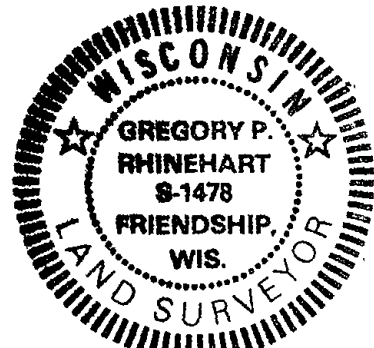


DATA SHOWN HERE ON  
CERTIFIED CORRECT:

*Gregory P Rhinehart*  
Registered Land Surveyor

DATE: 1-27-81

## TIE SKETCH

Show at least four ties, also fence lines, roads, topo, size and type of witness trees' and if off road - best way to arrive at corner.

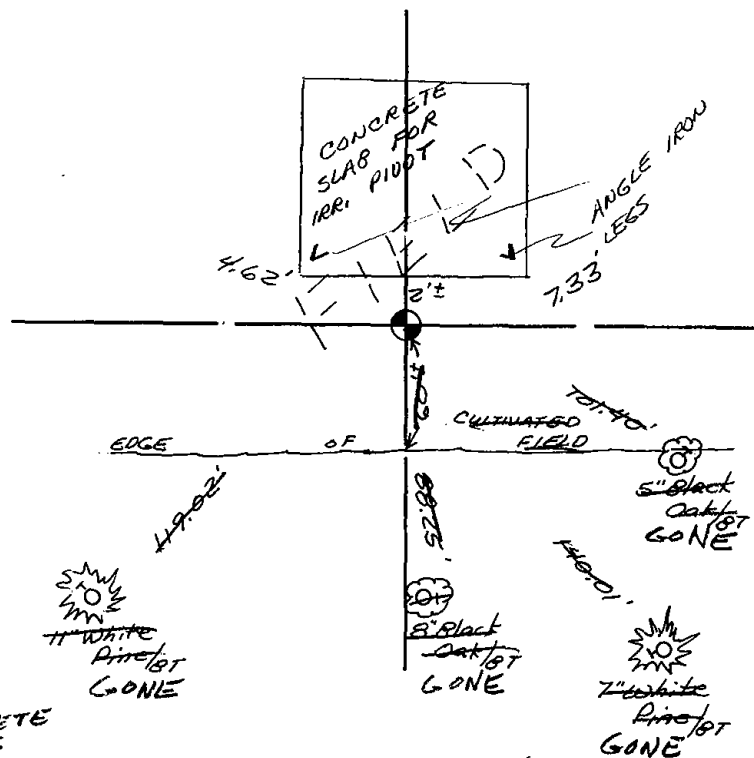

## MAINTENANCE RECORD

| Date     | Init. | Remarks   |
|----------|-------|---|
| 10-31-85 | MB-SS | TIES O.K. SET 3/4" ROD  |
| 1-30-90  | GR    | OK  |
| 2-2-95   | JG    | OK  |
| 2-28-05  | JG    | COMPLETE AREA AROUND THE PIVOT IS IRRIGATION FIELD ONLY TIES ARE ON CONCRETE SLAB - SAME 1-20-10 SS |