## **Government Land Corner Certificate**

ADAMS	County
TYPE OF MONUMENT: HARRISON	·
STATE PLANE COORDINATES: N	
	·····
ELEVATION — M.S.L. DATUM:	
THETA ANGLE:	
FIELD BOOK: A-F /	PAGE
DRAWN BY: S. SORENSEN	

## BASIS FOR MONUMENT LOCATION

Show info such as: History of corner, with reference to Vol. and pg., dates, surveyor; exact description of monument replaced; if location computed, by taped or EDM traverse; landowner remarks, etc. (Use reverse side if necessary)

During an EDM-Transit traverse of Section10-16-6 a 27"X12"X6" pointed sandstone was found lying on top of the ground near a new fence corner post. Excavation by hand revealed the stain from said stone at the intersection of two very old fences. Further investigation revealed a hollow, but living, 28" White Oak that matches the bearing and distance of the original White oak bearing tree by Surveyor James in October 1951. Set Standard Harrison Monument at location of stain and left stone lying adjacent to and south of the Harrison.

CORNER NO. 37
SECTION 10
TOWN 16
RANGE 6

LOCATION
(Indicated by 'X')

SEAL:

GREGORY PRINCEPLANT
STATE
PRIENDSHIP
WIS.
SURVEY
MIS.
SURVEY
MIS.
SURVEY
MIS.

DATA SHOWN HERE ON CERTIFIED CORRECT:

Registered and Surveyor


DATE: 6/9/80

## TIE SKETCH

Show at least four ties, also fence lines, roads, topo, size and type of witness trees' and if off road - best way to arrive at corner.

## MAINTENANCE RECORD

Date	Init.	Remarks
10-31-85	MB-55	O.K.
1-8-90	GR-KZ	OK
2-2-95	JG	2-NEW
12-07-00	56	ALL OK
3-1-05	56	ALL OK
1-20-10	55	TIES OK

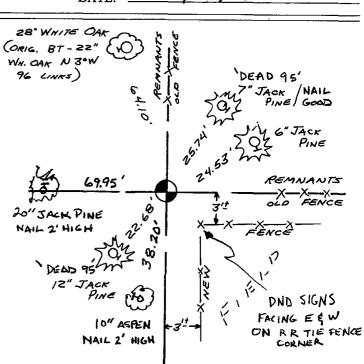

.,		
	<b>5</b> ·	