TOWN

OB ADAMS COUNTY

COUNTY CORNER NO: 40

ROMPORTOL ID: 41606122000

PUBLIC LAND SURVEY MONUMENT RECORD


TYPE OF MONUMENT: **HARRISON** ADAMS COUNTY COORDINATES, NAD 83 (2007) N. **188454.016** E. 557675.280 DATUM --ELEVATION-11/20/2017 FIELD WORK DATE:

BASIS FOR MONUMENT LOCATION


1972 - PLS 981 SET 30" HARRISON MONUMENT AT THE CORNER LOCATION AND TIED OUT.

1999 - PLS 1397 EXISTING MONUMENT WAS FOUND AT THE CORNER LOCATION. MONUMENT WAS REMOVED AND RAISED DUE TO RECONSTRUCTION OF C.T.H. B AND RE-TIED.

2017 - PLS 2994 FOUND A HARRISON MONUMENT 6" BELOW THE ROAD SURFACE. FOUND NO EVIDENCE OF ANY TIES OR WITNESSES. ACCEPTED THE HARRISON MONUMENT AS THE CORNER LOCATION. SET 4 NEW TIES AND MEASURED TO THE TIES.

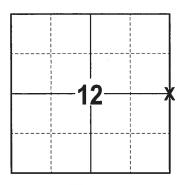

LOCATION (INDICATE CORNER BY "X")

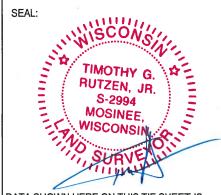


DATA SHOWN HERE ON THIS TIE SHEET IS CORRECT AND COMPLETE TO THE BEST OF MY KNOWLEDGE AND BELIEF.


PROFESSIONAL LAND SURVEYOR

DATE 12-21-17

- TIE SKETCH -

NOTE: THE CORNER FALLS 39'± NORTH OF THE CENTERLINE OF THE TRAIL ON THE EAST SIDE OF CTH B.

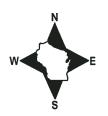


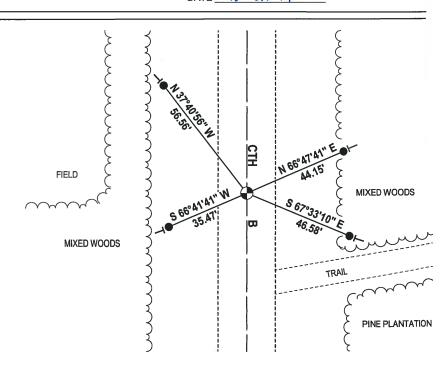

3/4" x 18" IRON REBAR SET, 1.50#/FT THARRISON FOUND

→ VINYL "T" POST

ADAMS COUNTY CORNER NO. . SECTION Survey Monument Record TOWN 30" MARRISON TYPE OF MONUMENT: ___ STATE PLANE COORDINATES: N. RANGE ELEVATION - M.S.L. DATUM: _ THETA ANGLE: . FIELD BOOK: _____103 _____ PAGE _________ BASIS FOR MONUMENT LOCATION (Use reverse side if necessary) Show info such as: History of corner, with reference to Vol. and pg, dates, surveyor; exact description of monument replaced; if location computed, by taped or EDM traverse; landowner remarks, etc. LOCATION (Indicated by 'X') SEAL: Set monument April 26, 1972 Sam T. Mullen R.L.S. 5-981 5-23-90 CERTIFIED CORRECT: 10.2.75 COR C.K. MON BEERS TIES OK 10/20/80 KU-SK Registered Land Surveyor mon Reeps Ties ok 7-15-85 DK DATE:

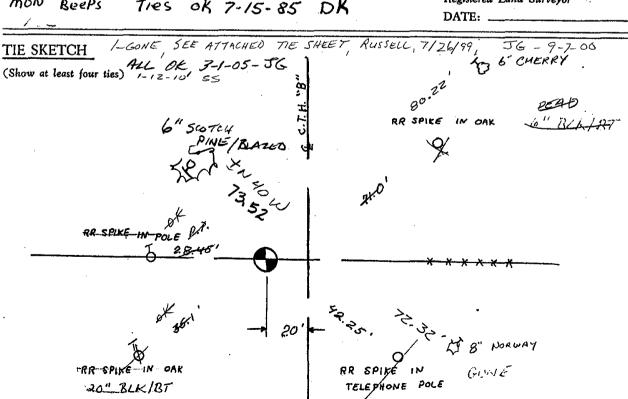

			4
			4
			4

TYPE OF MONUMENT: 30" HARRISON MARKER
STATE PLANE COORDINATES: N______

ELEVATION — M.S.L. DATUM:

THETA ANGLE: ______ PAGE _____

BASIS FOR MONUMENT LOCATION

(Use reverse side if necessary)


Show info such as: History of corner, with reference to Vol. and pg, dates, surveyor; exact description of monument replaced; if location computed, by taped or EDM traverse; landowner remarks, etc.

Existing Monument was found in place. Monument was removed and raised due to reconstruction of C.T.H. "B". All tie measurements are horizontal measurements unless noted otherwise.
 CORNER NO.
 95

 SECTION
 12

 TOWN
 16N

 RANGE
 6E

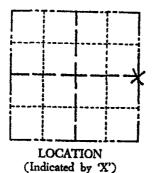

SEAL:



CERTIFIED CORRECT

Registered Land Serveyor

ALL MEASUREMENTS ARE HORIZONTAL.

DATE: July 26, 1999

TIE SKETCH

(Show at least four ties)

8" PINE

POWER POLE
SET PK

14" OAK

14" OAK

X X X CORNER FP
SET PK

20'±
2'
2'
2'

핅

A