


# Government Land Corner Certificate

Adams County  
 TYPE OF MONUMENT: HARRISON  
 STATE PLANE COORDINATES: N \_\_\_\_\_  
 E \_\_\_\_\_  
 ELEVATION — M.S.L. DATUM: \_\_\_\_\_  
 THETA ANGLE: \_\_\_\_\_  
 FIELD BOOK: 54 (101) PAGE 41 (112)  
 DRAWN BY: G RHINEHART

CORNER NO. 50  
 SECTION 11  
 TOWN 16  
 RANGE 6

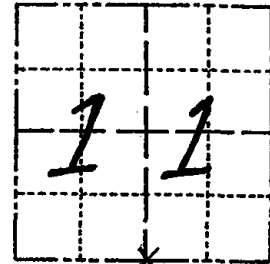


## BASIS FOR MONUMENT LOCATION

Show info such as: History of corner, with reference to Vol. and pg., dates, surveyor; exact description of monument replaced; if location computed, by taped or EDM traverse; landowner remarks, etc. (Use reverse side if necessary)

Excavated with backhoe. Found bottom 8" of 2½" diameter wood stake, pointed, very rotted. Accepted as corner. No other evidence found. No resurveys on record. Corner verified by EDM traverse.

SEAL:

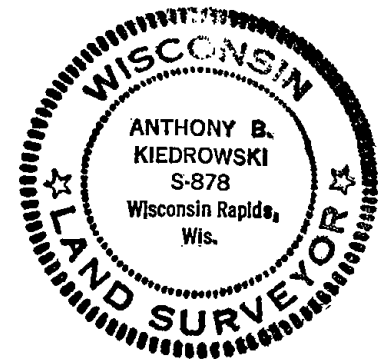


DATA SHOWN HERE ON CERTIFIED CORRECT:

*Anthony B. Kiedrowski*  
 Registered Land Surveyor

DATE: 1/31/28

## TIE SKETCH

Show at least four ties, also fence lines, roads, topo, size and type of witness trees' and if off road - best way to arrive at corner.

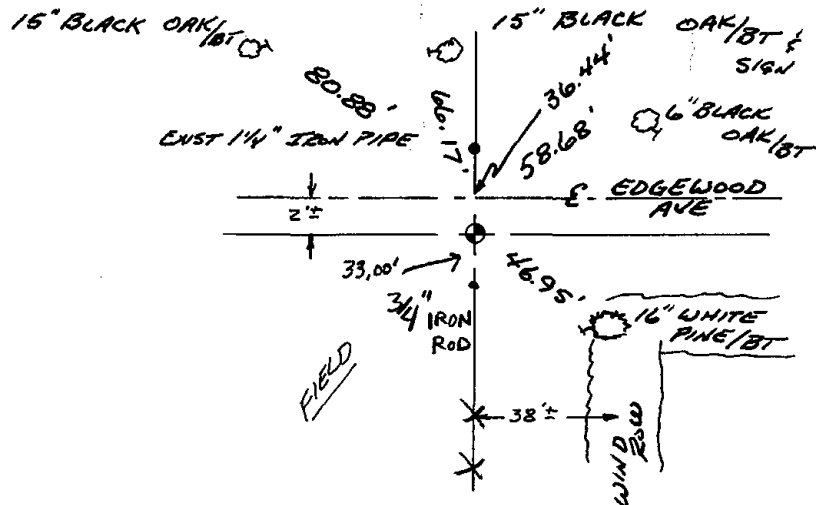

## MAINTENANCE RECORD

Date	Init.	Remarks
7-15-85	DK	ALL OK
1-09-89	GR-KZ	OK
1-23-95	JG-GR	NEW TIE
2-16-00	JG-SS	OK
2-24-05	JG	OK
1-12-10	SS	OK