

ADAMS COUNTY

Survey Monument Record

TYPE OF MONUMENT: 30" HARRISON

STATE PLANE COORDINATES: N _____

E _____

ELEVATION — M.S.L. DATUM: _____

THETA ANGLE: _____

FIELD BOOK: 103 PAGE 49


51

CORNER NO. 97

SECTION 12

TOWN 16

RANGE 6

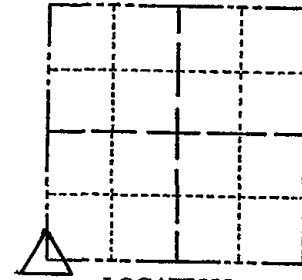

LOCATION (Indicated by 'X')

SEAL:

BASIS FOR MONUMENT LOCATION

(Use reverse side if necessary)

Show info such as: History of corner, with reference to Vol. and pg, dates, surveyor; exact description of monument replaced; if location computed, by taped or EDM traverse; landowner remarks, etc.

Set monument

April 26, 1972

Sam T. Mullen R.L.S. S-981

Cor o.k. 10-2-75 SS
CGR OK 10/15/80 KV-RN
1 GONE NO NEW 7-15-85
1-30-90 OK GK
1-23-95 OK JG-GR

CERTIFIED CORRECT:

Registered Land Surveyor

DATE: _____

TIE SKETCH ALL OK, 2-16-00, JG-SS
1-GONE 1-NEW 2-24-05-JG
(Show at least four ties) 1-12-10' OK SS

