SECTION

OB ADAMS COUNTY

COUNTY CORNER NO: 53

ROMPORTOL ID: 41606120000

PUBLIC LAND SURVEY MONUMENT RECORD


TYPE OF MONUMENT: HARRISON ADAMS COUNTY COORDINATES, NAD 83 (2007) N. **185813.686** E. 557662.399 **ELEVATION-**DATUM - -11/20/2017 FIELD WORK DATE:

BASIS FOR MONUMENT LOCATION


1972 - PLS 981 SET 30" HARRISON MONUMENT AT THE CORNER LOCATION AND TIED OUT.

1999 - PLS 1397 EXISTING MONUMENT WAS FOUND AT THE CORNER LOCATION. MONUMENT WAS REMOVED AND RAISED DUE TO RECONSTRUCTION OF C.T.H. B AND RE-TIED.

2017 - PLS 2994 FOUND A HARRISON MONUMENT 6" BELOW THE ROAD SURFACE, FOUND NO EVIDENCE OF ANY TIES OR WITNESSES. ACCEPTED THE HARRISON MONUMENT AS THE CORNER LOCATION. SET 4 NEW TIES AND MEASURED TO THE TIES.

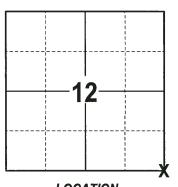

LOCATION (INDICATE CORNER BY "X")

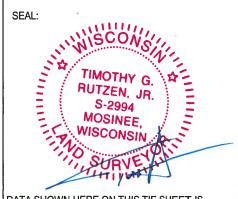

DATA SHOWN HERE ON THIS TIE SHEET IS CORRECT AND COMPLETE TO THE BEST OF MY KNOWLEDGE AND BELIEF.


PROFESSIONAL LAND SURVEYOR

12-21-17

- TIE SKETCH

NOTE: THE CORNER FALLS 1'± SOUTH OF THE CENTERLINE OF EDGEWOOD AVE AND 2'± WEST OF THE CENTERLINE OF CTH B.



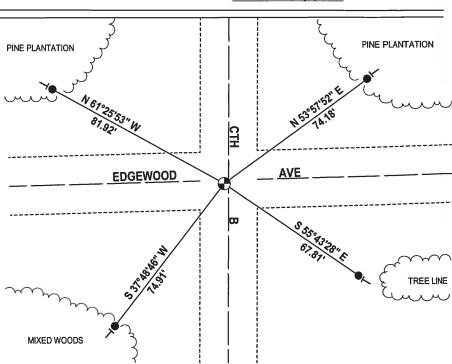

3/4" x 18" IRON REBAR SET, 1.50#/FT HARRISON FOUND → VINYL "T" POST

| ADAMS COUNTY | | CORNER NO | 94 |
|--|----------------------|-------------------|--------------------|
| | | | 12 |
| Survey Monument Record | | | 16 |
| TYPE OF MONUMENT: 30" HARRISON | | | <u> </u> |
| STATE PLANE COORDINATES: N | | RANGE _ | _6 |
| ELEVATION — M.S.L. DATUM: | | | 7 / |
| THETA ANGLE: | ļ | | |
| FIELD BOOK: PAGE | İ | | |
| | | | |
| BASIS FOR MONUMENT LOCATION | | | |
| (Use reverse side if necessary) | | | $\dot{\mathbf{A}}$ |
| Show info such as: History of corner with reference to Vol | | LOCATION | =7. |
| and pg, dates, surveyor; exact description of monument replaced; if location computed, by taped or EDM traverse; landowner remarks, etc. | SEAL: | Indicated by 'X') | |
| Set monument | | | |
| April 26, 1972 | | | |
| Sam T. Mullem R.L.S. s=981 | | | |
| Harrison O.K. 10-2-75 S.S. COR OK 10/18/80 KV-RN I GONE NO NEW 7-15-85 DK | CERTIFIED | CORRECT: | |
| ALL OK 1-9-90 GR-KZ | Registered Lan | d Surveyor | |
| ALL OK 1/23/95 JG-GR | DATE: | - | |
| TIE SKETCH ALL OK SEE ATTACHED TIE SHEET RUSSELL (Show at least four ties) 1-12-13 SEE ATTACHED TIE SHEET RUSSELL (Show at least four ties) 1-12-13 SEE ATTACHED TIE SHEET RUSSELL | 7/26/99 , = | _ | 00 |
| RR SPIKE IN PINE | Telephone | POLE GONE | |
| 34.65' | | | |
| | EWOOD AY | E | |
| GONE STATE SHE | HETION BOX | PHONE | |
| No nail FENCE CORNER | "NORWAY / | BT | |

1990

SE CIR. HIGH VOLTAGE BOX

ADAMS COUNTY

Survey Monument Record

TYPE OF MONUMENT: 30" HARRISON MARKER
STATE PLANE COORDINATES: N______

ELEVATION — M.S.L. DATUM: ______THETA ANGLE: _____

FIELD BOOK: ______ PAGE _____


BASIS FOR MONUMENT LOCATION


(Use reverse side if necessary)

Show info such as: History of corner, with reference to Vol. and pg, dates, surveyor; exact description of monument replaced; if location computed, by taped or EDM traverse; landowner remarks, etc.

Existing Monument was found in place. Monument was removed and raised due to reconstruction of C.T.H. "B". All tie measurements are horizontal measurements unless noted otherwise.


ALL OK, 2-16-00, J6-55

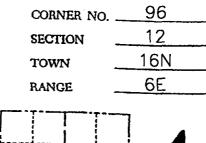


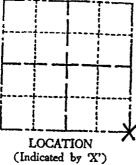

SEAL:



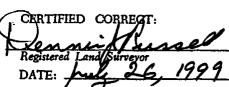

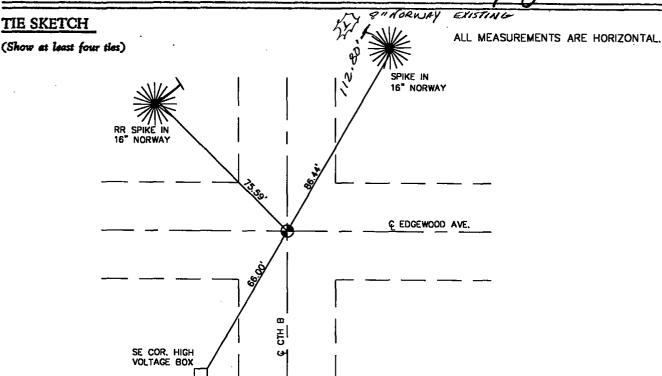

N

