ADAMS COUNTY

Survey Monument Record


TYPE OF MONUMENT: Standard Harrison
STATE PLANE COORDINATES: N______

E_____

ELEVATION — M.S.L. DATUM:

THETA ANGLE:

FIELD BOOK: PAGE _____

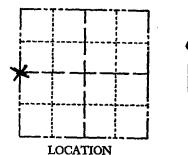

CORNER NO. 931

SECTION

TOWN

RANGE

SEAL:

BASIS FOR MONUMENT LOCATION

(Use reverse side if necessary)

Show info such as: History of corner, with reference to Vol. and pg, dates, surveyor; exact description of monument replaced; if location computed, by taped or EDM traverse; landowner remarks, etc.

Ran EDM/transit traverse around Section 13 and to adjacent section corners to determine search areas.

Excavation yielded no evidence of the original corner or any remonumentations

Set corner by single proportionate measure between the Southwest and the Northwest corners of Section 13.

COR OK 10/15/80 KV-RN

I GONE 7-15-85 DK

OK 1-30-90 GR

OK 4-22-93 MC

ALL OK 1-23-95 JG-GR

ALL OK, 2-16-00, TG-SS

ALL OK, 2-24-05-JG

DALE C.
HAGEN
S-1103
Wisconsin Rapids,
Wis.

CERTIFIED CORRECT:


Registered Land Surveyor
DATE: January 23, 197

TIE SKETCH 1-12-10 OK

(Show at least four ties)

NOTE:

Ties in trees to nail in disc.

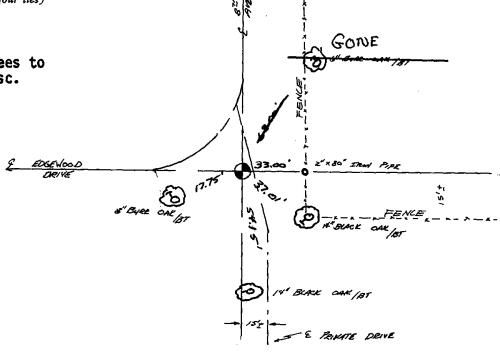

AN