

# ADAMS COUNTY U.S. PUBLIC LAND SURVEY MONUMENT LOCATION RECORD

CORNER # 63  
 SECTION 20  
 TOWNSHIP 16 NORTH  
 RANGE 6 EAST

- FOUND
- SET
- RE-SET
- RE-TIED

LANDMARK     BENCHMARK \_\_\_\_\_  
 CORNER IDENTITY BERNTSEN SURVEY NAIL SET  
 COUNTY COORDINATES:    N. 180,536.81  
     E. 531,195.56  
 ELEVATION \_\_\_\_\_  
 WEATHER \_\_\_\_\_  
 DATE OF SURVEY June 23, 2013  
 SURVEY PARTY Dennis J. Christie, RLS


SECTION 20

X			

## BASIS FOR MONUMENT LOCATION:

( DESCRIBE METHOD OF SURVEY AND CORNER AUTHENTICATION )

**MAG NAIL FOUND**

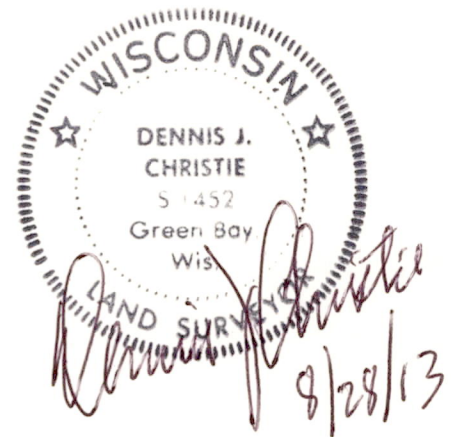

## TIE SKETCH:

SHOW MINIMUM OF FOUR (4) HORIZONTAL TIE DISTANCES TO FIXED WITNESS MONUMENTS.  
 DESCRIBE ALL MONUMENTS FOUND OR SET.

DRAWING IS NOT TO SCALE.

### LEGEND

- BERNTSEN SURVEY NAIL SET
- BERNTSEN MONUMENT A2BR30 SET

