

ADAMS COUNTY

Survey Monument Record

TYPE OF MONUMENT: 30" HARRISON


STATE PLANE COORDINATES: N _____ E _____

ELEVATION — M.S.L. DATUM: _____

THETA ANGLE: _____

FIELD BOOK: 501 PAGE 2

CORNER NO. 744
SECTION 16
TOWN 16 N
RANGE 6 E

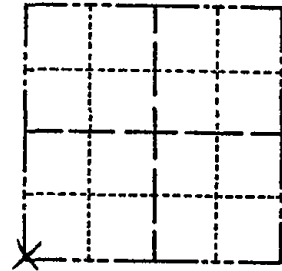

BASIS FOR MONUMENT LOCATION

(Use reverse side if necessary)

Show info such as: History of corner, with reference to Vol. and pg. dates, surveyor; exact description of monument replaced; if location computed, by taped or EDM traverse; landowner remarks, etc.

FOUND 1" X 24" IRON PIPE WITH PINCHED TOP AND MONUMENTED SAME

COR OK 10/17/80 KU-SK

1 NEW TIE -10-31-85 MB-SS


OK 1-15-90 GR

1-NEW TIE 2/3/95 JG

1 NEW TIE 2-16-00 SS

2-GONE, 2-NEW, 2-25-05- JG
MON 1/3 TIES COOP 1-13-10 SS

SEAL:

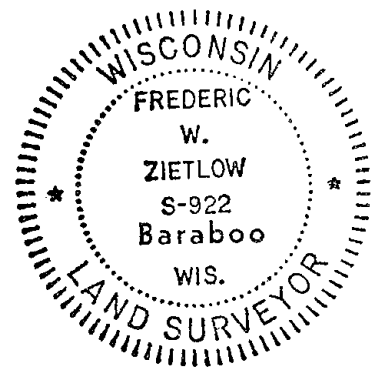

CERTIFIED CORRECT:

Frederic W. Zietlow

Registered Land Surveyor

DATE: MAY 9, 1975

TIE SKETCH

(Show at least four ties)

