

ADAMS COUNTY

Survey Monument Record

TYPE OF MONUMENT: 30" HARRISON

STATE PLANE COORDINATES: N _____

E _____

ELEVATION — M.S.L. DATUM: _____

THETA ANGLE: _____


FIELD BOOK: 102 PAGE 73

CORNER NO. 248 (69)

SECTION 22

TOWN 16

RANGE 6

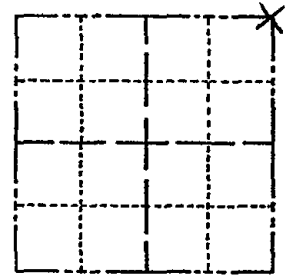

LOCATION (Indicated by 'X')

SEAL:



BASIS FOR MONUMENT LOCATION

(Use reverse side if necessary)

Show info such as: History of corner, with reference to Vol. and pg, dates, surveyor; exact description of monument replaced; if location computed, by taped or EDM traverse; landowner remarks, etc.

Excavated large area of dirt road. Found remnant of charcoal stake. Location verified by traverse of entire section. No other mark found.

Monumented stake.

Everything o.k. 10-18-75 S.S. D.M.
MON, BEERS-TIES OK 10/15/80 KU-RN

OK 7-9-85 DK

OK 1-30-90 GR

ALL OK 1-23-95 JG-GR

1-GONE, 3-NEW, 2-15-00, JG-SS

ALL OK 2-24-05-JG

OK 1-12-10 SS


CERTIFIED CORRECT:

Anthony B. Kiedrowski
Registered Land Surveyor

DATE: 9/29/12

TIE SKETCH

(Show at least four ties)

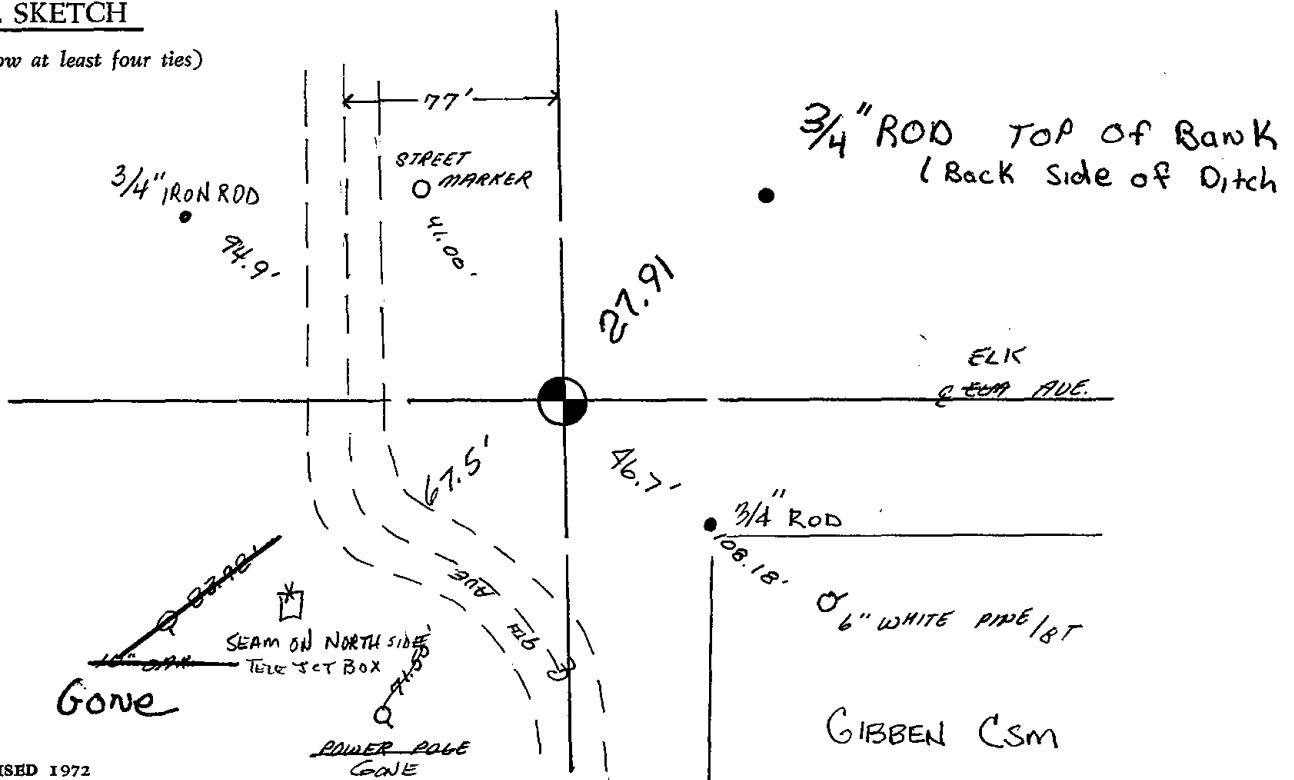

ADAMS COUNTY

Survey Monument Record

TYPE OF MONUMENT: 30" HARRISON

STATE PLANE COORDINATES: N _____


E _____

ELEVATION — M.S.L. DATUM: _____

THETA ANGLE: _____

FIELD BOOK: 102 PAGE 73

CORNER NO. 248 (69)
SECTION 22
TOWN 16
RANGE 6

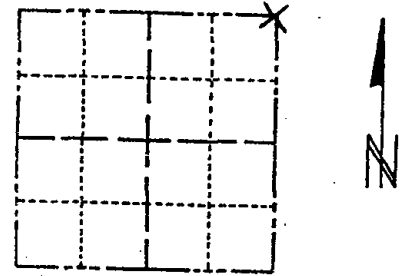

LOCATION
(Indicated by 'X')

SEAL:



BASIS FOR MONUMENT LOCATION

(Use reverse side if necessary)

Show info such as: History of corner, with reference to Vol. and pg, dates, surveyor; exact description of monument replaced; if location computed, by taped or EDM traverse; landowner remarks, etc.

Excavated large area of dirt road. Found remnant of charcoal stake. Location verified by traverse of entire section. No other mark found.

Monumented stake.

Everything o.k. 10-18-75 S.S. D.M.
MON, BEEPS-TIES OK 10/15/80 KV-RN

July 4 83 Ron Carlson

filed for record this 17th

day of August 1983
per 59.60 Wisconsin Statutes.

A. Kiedrowski
ADAMS COUNTY SURVEYOR


CERTIFIED CORRECT:

Anthony B. Kiedrowski
Registered Land Surveyor

DATE: 9/29/72

TIE SKETCH

(Show at least four ties)

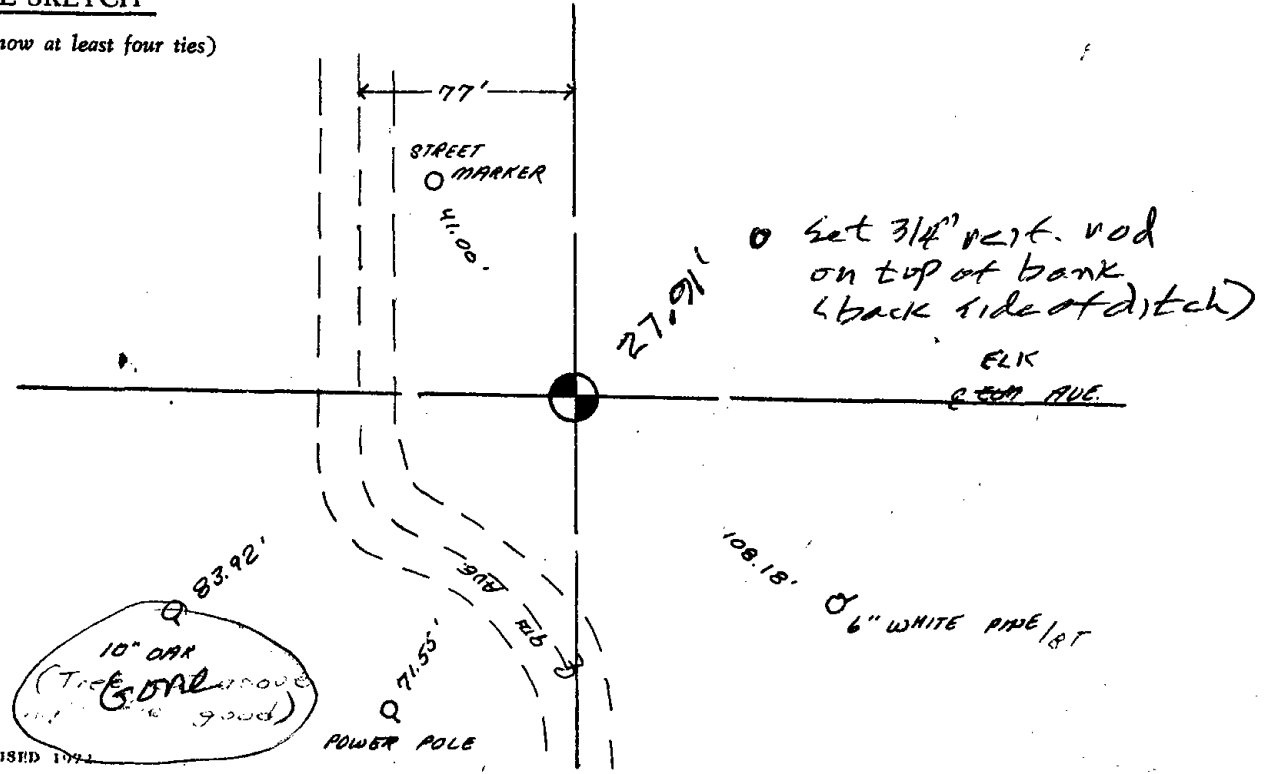

10/10/10

10/10/10
10/10/10
10/10/10