19 SECTION

16 TOWN

OG RANGE ADAMS COUNTY CORNER NO: 75 ROMPORTOL ID: 41606192000

PUBLIC LAND SURVEY MONUMENT RECORD

TYPE OF MONUMENT:

SURVEY NAIL

ADAMS COUNTY COORDINATES, NAD 83 (2007)

N. 177896.897

E. 531222.242

ELEVATION-


- — — _ DATUM_

FIELD WORK DATE: 11/18/2020

BASIS FOR MONUMENT LOCATION

2013 - PLS 1452 "PK" NAIL FOUND

2020 - PLS 2675 FOUND SURVEY NAIL IN THE ROAD SURFACE AND 4 TIES. THE MONUMENT AGREES WITH ALL 4 TIES. ACCEPTED THE SURVEY NAIL AS THE CORNER LOCATION AND MEASURED TO ALL EXISTING TIES.

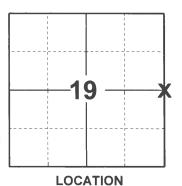

(INDICATE CORNER BY "X")



DATA SHOWN HERE ON THIS TIE SHEET IS CORRECT AND COMPLETE TO THE BEST OF MY KNOWLEDGE AND BELIEF.


PROFESSIONAL LAND SURVEYOR

2020

-TIE SKETCH

NOTE: THE CORNER LANDS 1'± EAST OF STH "13" CENTERLINE.



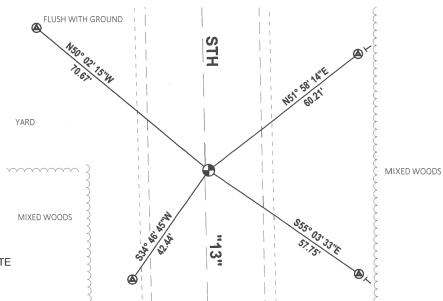

- FOUND WISDOT ALUMINUM CAP IN CONCRETE
- FOUND SURVEY NAIL MONUMENT
- → VINYL "T" POST

ADAMS COUNTY U.S. PUBLIC LAND SURVEY 75 CORNER # SECTION MONUMENT LOCATION RECORD TOWNSHIP NORTH RANGE EAST X RE-SET SECTION 20 X RE-TIED X LANDMARK BENCHMARK CORNER IDENTITY BERNTSEN SURVEY NAIL SET COUNTY COORDINATES: N. 177,897.02 E. 531,222.19 ELEVATION WEATHER DATE OF SURVEY June 24, 2013 SURVEY PARTY _____ Dennis J. Christie, RLS DENA C' BASIS FOR MONUMENT LOCATION: (DESCRIBE METHOD OF SURVEY AND CORNER AUTHENTICATION) "PK" NAIL FOUND SHOW MINIMUM OF FOUR (4) HORIZONTAL TIE DISTANCES TO FIXED WITNESS MONUMENTS. TIE SKETCH: DESCRIBE ALL MONUMENTS FOUND OR SET. DRAWING IS NOT TO SCALE. LEGEND BERNTSEN SURVEY NAIL SET 102.01 BERNTSEN MONUMENT A2BR30 SET S85° 21'21"E S88° 34'37" W