

## PUBLIC LAND SURVEY MONUMENT RECORD

TYPE OF MONUMENT: HARRISON  
 ADAMS COUNTY COORDINATES, NAD 83 (2007)

N. 177815.464  
 E. 541763.986


ELEVATION- \_\_\_\_\_ DATUM \_\_\_\_\_

FIELD WORK DATE: 11/04/2020

### BASIS FOR MONUMENT LOCATION

1972 - PLS 878 SET ON A STRAIGHT LINE EQUIDISTANT BETWEEN SECTION CORNERS. EXCAVATED AREA WITH A BACKHOE BUT FOUND NOTHING.


2020 - PLS 2675 FOUND HARRISON 6"± BELOW THE ROAD SURFACE AND 1 TIE. THE MONUMENT AGREES WITH THE EXISTING TIE. ACCEPTED THE HARRISON AS THE CORNER LOCATION. SET 3 NEW TIES AND MEASURED TO THE EXISTING TIE.

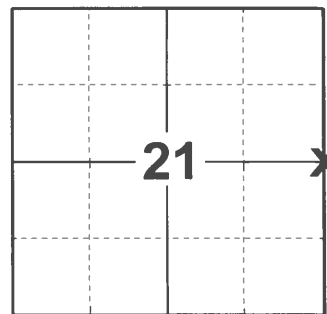

### LOCATION

(INDICATE CORNER BY "X")

SEAL:

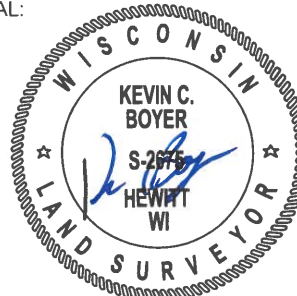



DATA SHOWN HERE ON THIS TIE SHEET IS CORRECT AND COMPLETE TO THE BEST OF MY KNOWLEDGE AND BELIEF.

PROFESSIONAL LAND SURVEYOR

DATE 12/3/2020

### - TIE SKETCH

NOTE: THE CORNER LANDS 6.2'± WEST OF 10TH AVE. CENTERLINE.

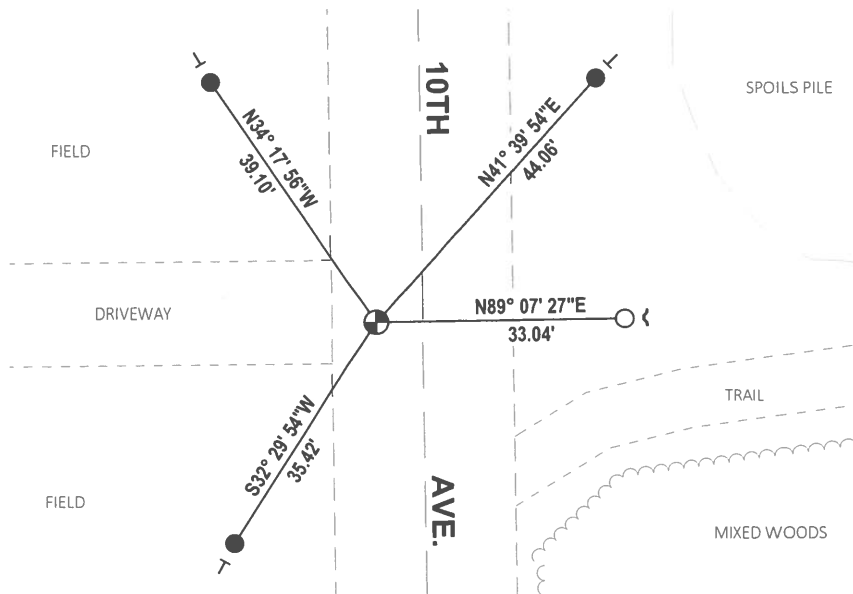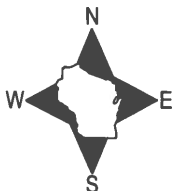

- SET 3/4" x 18" IRON REBAR, 1.50#/FT
- FOUND 3/4" IRON ROD
- ⊕ FOUND HARRISON MONUMENT
- ~ STEEL FENCE POST
- VINYL "T" POST

# ADAMS COUNTY

## Survey Monument Record

TYPE OF MONUMENT: 30" HARRISON

STATE PLANE COORDINATES: N \_\_\_\_\_

E \_\_\_\_\_

ELEVATION — M.S.L. DATUM: \_\_\_\_\_

THETA ANGLE: \_\_\_\_\_


FIELD BOOK: 102 PAGE 71

CORNER NO. 245

SECTION 22

TOWN 16

RANGE 6

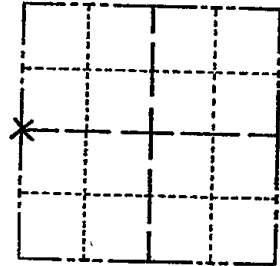

LOCATION  
(Indicated by 'X')

SEAL:

### BASIS FOR MONUMENT LOCATION

(Use reverse side if necessary)

Show info such as: History of corner, with reference to Vol. and pg, dates, surveyor; exact description of monument replaced; if location computed, by taped or EDM traverse; landowner remarks, etc.

Set on a straight line equidistant between section corners. Excavated area with a backhoe but found nothing.

Everything O.K. 10-18-75 S.S.-D.M.  
 COR OK 10/16/80 KU-RN  
 " " 10-31-85 MIB-SS  
 COR. OK 1-30-90 GR  
 OK 1/31/95 CR-JG  
 2-GONE, 2-NEW, 2-16-00, JG-SS  
 3-GONE, 2-NEW, 2-22-05-JG  
 1-12-10 OK SS



CERTIFIED CORRECT:

*Anthony B. Kiedrowski*  
 Registered Land Surveyor

DATE: 9/28/72

### TIE SKETCH

(Show at least four ties)

