O6 RANGE ADAMS COUNTY CORNER NO: 78 ROMPORTOL ID: 41606222000


PUBLIC LAND SURVEY MONUMENT RECORD

HARRISON TYPE OF MONUMENT: ADAMS COUNTY COORDINATES, NAD 83 (2007) N. 177884.086 E. 547072.699 ELEVATION-_ __ DATUM 10/30/2020 FIELD WORK DATE:

BASIS FOR MONUMENT LOCATION

1973 - PLS 878 SET ON A STRAIGHT LINE EQUIDISTANT BETWEEN SECTION CORNERS. DID NOT EXCAVATED BECAUSE OF DEEP FILL.

2020 - PLS 2675 FOUND HARRISON 10"± BELOW THE ROAD SHOULDER AND 1 WITNESS. THE MONUMENT AGREES WITH THE WITNESS. ACCEPTED THE HARRISON AS THE CORNER LOCATION. SET 4 NEW TIES AND MEASURED TO THE EXISTING

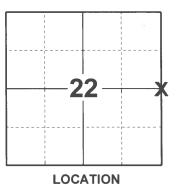

(INDICATE CORNER BY "X")



DATA SHOWN HERE ON THIS TIE SHEET IS CORRECT AND COMPLETE TO THE BEST OF MY KNOWLEDGE AND BELIEF


PROFESSIONAL LAND SURVEYOR

DATE

-TIE SKETCH

NOTE: THE CORNER LANDS 2.5'± SOUTH OF THE SOUTH PAVEMENT EDGE OF ELK DR.



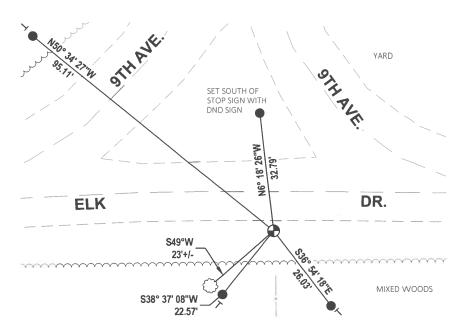

- SET 3/4" x 18" IRON REBAR, 1.50#/FT
- FOUND HARRISON MONUMENT
 - VINYL "T" POST
- WITNESS TREE

ADAMS COUNTY CORNER NO. _ **SECTION** Survey Monument Record TOWN TYPE OF MONUMENT: 30" HPRRISON RANGE STATE PLANE COORDINATES: N_ E ELEVATION - M.S.L. DATUM: -THETA ANGLE: _ 102 FIELD BOOK: ____ _ PAGE __ BASIS FOR MONUMENT LOCATION (Use reverse side if necessary) LOCATION Show info such as: History of corner, with reference to Vol. and pg, dates, surveyor; exact description of monument replaced; if location computed, by taped or EDM traverse; landowner (Indicated by 'X') SEAL: remarks, etc. Set on a straight line equidistant between section corners. Did not excavate because of deep fill. ANTHONY B. KIEDROWSKI S-878 Wisconsin Rapids. Wis. Z NEW TIES, 2-21-00 55 OK 1/31/95 CR-UG HAKRISPN O.E. 10-14.75 55 CERTIFIED CORRECT: COR OR 10/15/80 KU-RN ALL OK 7-9-85 Registered Land OK 1-30-90 GR 1-GONE, 2-24-05-56 DATE: TIE SKETCH 143-10 (Show at least four ties) 6" BEACK O ELK PRIVE WHITE Q OAK'OO NAIL I 4' MICH ZO"WHITE

STUMP"

NAIL STILL GOOD

PINE 100 NAIL IS' HIGH