

19
SECTION

16
TOWN

06
RANGE

ADAMS COUNTY

COUNTY CORNER NO: 82

ROMPORTOL ID: 41606190020

PUBLIC LAND SURVEY MONUMENT RECORD

TYPE OF MONUMENT: HARRISON
ADAMS COUNTY COORDINATES, NAD 83 (2007)

N. 175269.632

E. 528615.218


ELEVATION- DATUM

FIELD WORK DATE: 11/18/2020

BASIS FOR MONUMENT LOCATION

1977 - PLS 878 RAN EDM/T2 TRAVERSE AROUND SECTION 30 AND SECTION 19 TO DETERMINE SEARCH AREAS. A.B. KIEDROWSKI, COUNTY SURVEYOR, EXCAVATED WITH BACKHOE IN SEARCH OF CORNER, BUT NO EVIDENCE OF THE CORNER WAS FOUND. RELOCATED CORNER BY SINGLE PROPORTIONATE MEASURE ON LINE BETWEEN ADJACENT SECTION CORNERS. HARRISON MONUMENT SET 5-19-77.

2020 - PLS 2675 FOUND HARRISON 4"± UNDER THE ROAD SHOULDER AND 2 WITNESSES. THE MONUMENT AGREES WITH BOTH WITNESSES. ACCEPTED THE HARRISON AS THE CORNER LOCATION. SET 4 NEW TIES AND MEASURED TO THE EXISTING WITNESSES.

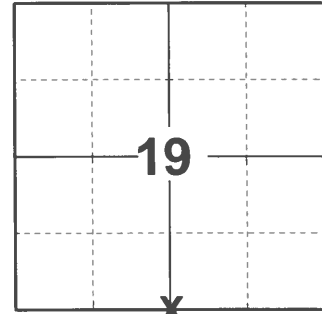

LOCATION

(INDICATE CORNER BY "X")

SEAL:





DATA SHOWN HERE ON THIS TIE SHEET IS CORRECT AND COMPLETE TO THE BEST OF MY KNOWLEDGE AND BELIEF.

PROFESSIONAL LAND SURVEYOR

DATE 12/3/2020

- TIE SKETCH

NOTE: THE CORNER LANDS 9'± NORTH OF EMBER AVE. CENTERLINE.

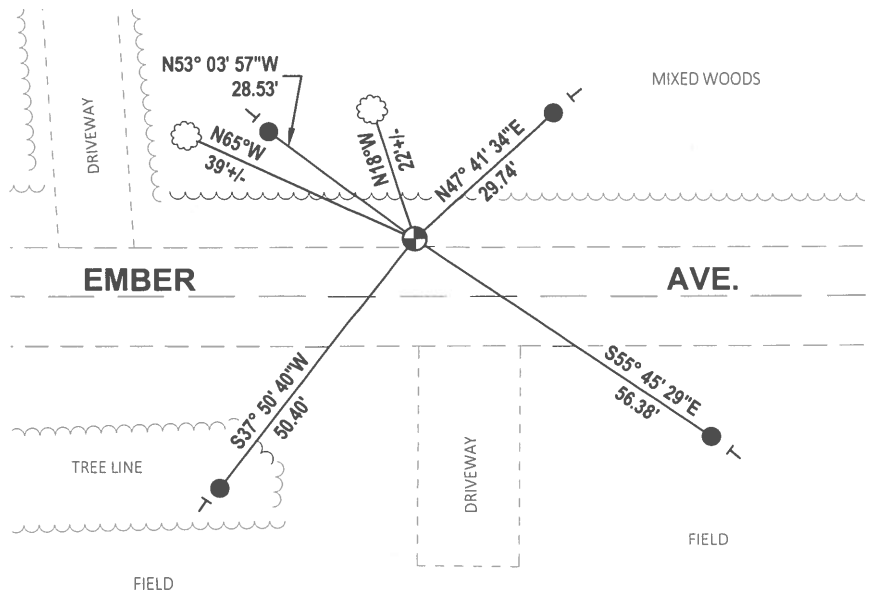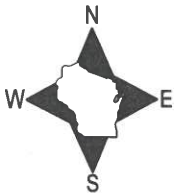


- SET 3/4" x 18" IRON REBAR, 1.50#/FT
- ⊕ FOUND HARRISON MONUMENT
- ┆ VINYL "T" POST
- ⊙ WITNESS TREE

Government Land Corner Certificate

82

ADAMS County
 TYPE OF MONUMENT: HARRISON
 STATE PLANE COORDINATES: N _____
 E _____
 ELEVATION — M.S.L. DATUM: _____
 THETA ANGLE: _____
 FIELD BOOK: 38 PAGE 42
 DRAWN BY: D.C. HAGEN

CORNER NO. 82
 SECTION 30
 TOWN 16 N
 RANGE 6 E

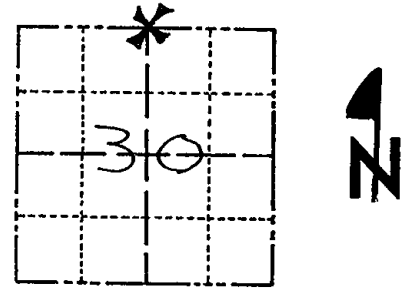

LOCATION
(Indicated by 'X')

BASIS FOR MONUMENT LOCATION

Show info such as: History of corner, with reference to Vol. and pg., dates, surveyor; exact description of monument replaced; if location computed, by taped or EDM traverse; landowner remarks, etc. (Use reverse side if necessary)


Ran EDM/T2 traverse around Section 30 and Section 19 to determine search areas.

A.B. Kiedrowski, County Surveyor, excavated with backhoe in search of corner, but no evidence of the corner was found.

Relocated corner by single proportionate measure on line between adjacent section corners.

Harrison monument set 5-19-77.

SEAL:

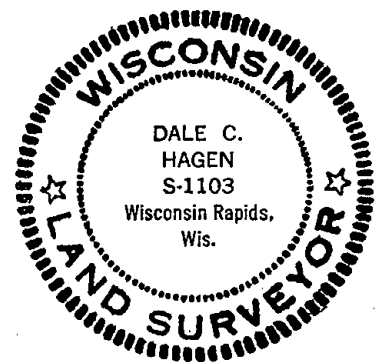

DATA SHOWN HERE ON CERTIFIED CORRECT:

Dale C Hagen
 Registered Land Surveyor


DATE: 5-23-77

TIE SKETCH

Show at least four ties, also fence lines, roads, topo, size and type of witness trees' and if off road - best way to arrive at corner.

NOTE:

Ties in trees to nail in disc.

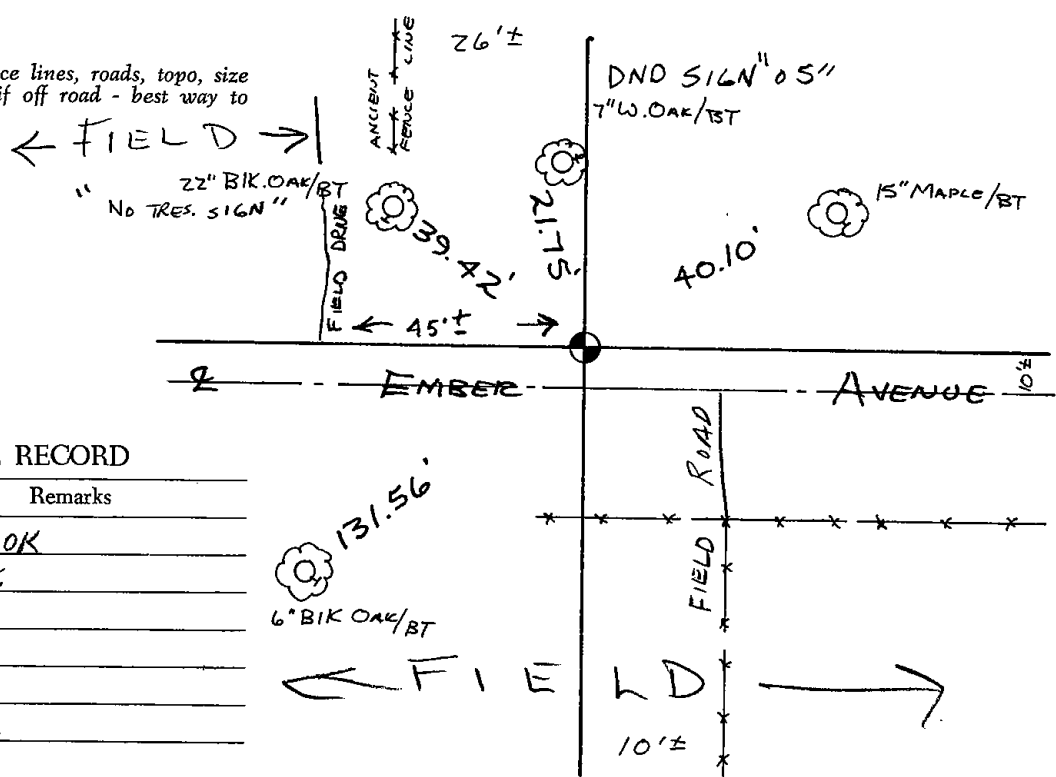

MAINTENANCE RECORD

Date	Init.	Remarks
10-17-80	KV-SK	COR OK
10-29-85	MB-SS	O.K.
1-15-90	GR	OK
2-6-95	SG-GR	OK
4-24-00	JG	OK
2-25-05	JG	OK
1-13-10	SS	OK