# ADAMS COUNTY COUNTY COUNTY CORNER NO: 83 ROMPORTOL ID: 41606190000

### PUBLIC LAND SURVEY MONUMENT RECORD

**SURVEY NAIL** TYPE OF MONUMENT: ADAMS COUNTY COORDINATES, NAD 83 (2007) N. 175257.118

ELEVATION- - - -DATUM - -


FIELD WORK DATE: 11/18/2020

E. 531248.855


#### BASIS FOR MONUMENT LOCATION

2013 - PLS 1452 "PK" NAIL FOUND

2020 - PLS 2675 FOUND SURVEY NAIL IN THE ROAD SURFACE AND 4 TIES (NW WAS DISTURBED). THE MONUMENT AGREES WITH THE 3 GOOD TIES. ACCEPTED THE SURVEY NAIL AS THE CORNER LOCATION. RE-SET THE NW TIE AND MEASURED TO THE EXISTING TIES.

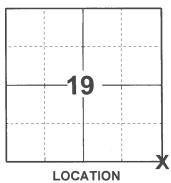

(INDICATE CORNER BY "X")

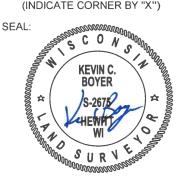

DATA SHOWN HERE ON THIS TIE SHEET IS CORRECT AND COMPLETE TO THE BEST OF MY KNOWLEDGE AND BELIEF.


PROFESSIONAL LAND SURVEYOR

12020

#### -TIE SKETCH

NOTE: THE CORNER LANDS 3'± EAST OF STH "13" CENTERLINE AND 3'± SOUTH OF EMBER AVE. CENTERLINE.



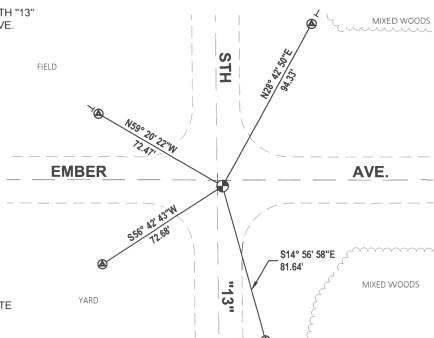

FOUND WISDOT ALUMINUM CAP IN CONCRETE

FOUND SURVEY NAIL MONUMENT

VINYL "T" POST

## ADAMS COUNTY U.S. PUBLIC LAND SURVEY CORNER # SECTION MONUMENT LOCATION RECORD TOWNSHIP NORTH X FOUND SET RANGE EAST X RE-SET X RE-TIED SECTION 20 X LANDMARK BENCHMARK CORNER IDENTITY BERNTSEN SURVEY NAIL SET COUNTY COORDINATES: N. 175,257.12 E. 531,248.87 ELEVATION WEATHER DATE OF SURVEY June 24, 2013 SURVEY PARTY Dennis J. Christie, RLS BASIS FOR MONUMENT LOCATION: (DESCRIBE METHOD OF SURVEY AND CORNER AUTHENTICATION ) "PK" NAIL FOUND. SHOW MINIMUM OF FOUR (4) HORIZONTAL TIE DISTANCES TO FIXED WITNESS MONUMENTS. TIE SKETCH: DESCRIBE ALL MONUMENTS FOUND OR SET. DRAWING IS NOT TO SCALE. LEGEND BERNTSEN SURVEY NAIL SET BERNTSEN MONUMENT A2BR30 SET CL EMBER AVE.