TOWN

ADAMS COUNTY COUNTY COUNTY CORNER NO: 84

ROMPORTOL ID: 41606200020

PUBLIC LAND SURVEY MONUMENT RECORD

HARRISON TYPE OF MONUMENT: ADAMS COUNTY COORDINATES, NAD 83 (2007) N. 175257.516 E. 533888.899 ELEVATION- - - -DATUM - ---FIELD WORK DATE: 11/17/2020


BASIS FOR MONUMENT LOCATION

1975 - PLS 878 EXCAVATED WITH BACKHOE AND FOUND FRACTURED SANDSTONE 8"X10"X10" BESIDE STAIN FROM 4" WOOD POST. MONUMENTED POST AND LOWERED STONE AND SET HARRISON MONUMENT ON TOP. WITNESSED BY JOHN BREENE OF EASTON TOWN BOARD, RICHARD HIGBY, CHARLES GIBBONS AND ORVILLE DAY.

2020 - PLS 2675 FOUND HARRISON 2"± BELOW THE ROAD SURFACE AND 2 WITNESSES. THE MONUMENT AGREES WITH BOTH WITNESSES. ACCEPTED THE HARRISON AS THE CORNER LOCATION. SET 4 NEW TIES AND MEASURED TO THE EXISTING WITNESSES.



(INDICATE CORNER BY "X")

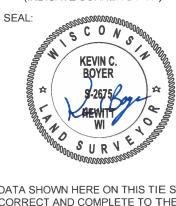


DATA SHOWN HERE ON THIS TIE SHEET IS CORRECT AND COMPLETE TO THE BEST OF MY KNOWLEDGE AND BELIEF.

PROFESSIONAL LAND SURVEYOR 12020 DATE /

-TIE SKETCH

NOTE: THE CORNER LANDS 7'± NORTH OF EMBER AVE. CENTERLINE.



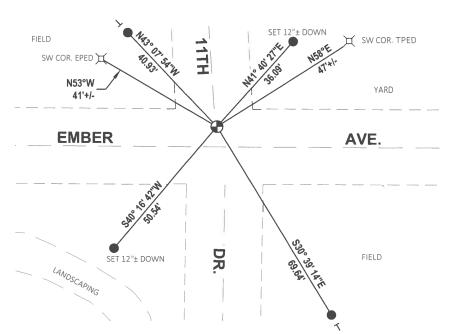

- SET 3/4" x 18" IRON REBAR, 1.50#/FT
 - FOUND HARRISON MONUMENT
- VINYL "T" POST

ADAMS COUNTY

Survey Monument Record

TYPE OF MONUMENT: _______

STATE PLANE COORDINATES: N______

ELEVATION — M.S.L. DATUM: ______

THETA ANGLE: ______

FIELD BOOK: ______ PAGE _____

BASIS FOR MONUMENT LOCATION

(Use reverse side if necessary)

Show info such as: History of corner, with reference to Vol. and pg, dates, surveyor; exact description of monument replaced; if location computed, by taped or EDM traverse; landowner remarks, etc.

Excavated with backhoe and found fractured sandstone 8"x10"x10" beside stain from 4" wood post. Monumented post and lowered stone and set Harrison monument on top. Witnessed by John Breene of Easton Town Board, Richard Higby, Charles Gibbons and Orville Day.

COR OK 10/16/80 KU-KN

ALL OX 6-26-85 GR-SS


OK 1-30-90 GR

ALL OK 1-9-95 JG-BS

ALL OK 2-16-00 JG-55

2-NEW, 2-24-05-JG

1-13-10 OK SS

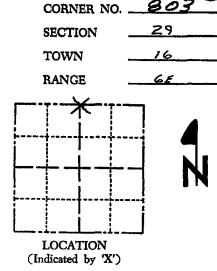

SEAL:



CERTIFIED CORRECT:

And Surveyor

DATE:

TIE SKETCH

(Show at least four ties)

