TOWN

O6 RANGE ADAMS COUNTY COUNTY CORNER NO: 87 ROMPORTOL ID: 41606210000

PUBLIC LAND SURVEY MONUMENT RECORD

TYPE OF MONUMENT: ADAMS COUNTY COORDINATES, NAD 83 (2007) N. 175145.861 E. 541775.808 ELEVATION-DATUM_ 11/04/2020 FIELD WORK DATE:


BASIS FOR MONUMENT LOCATION

1972 - PLS 878 EXCAVATED AREA WITH A BACKHOE. FOUND CHARCOAL PIT. MONUMENTED SAME. LOCATION VERIFIED BY A TRAVERSE OF THE ENTIRE SECTION.

2020 - PLS 2675 FOUND HARRISON 2"± BELOW THE ROAD SURFACE AND 2 WITNESSES. THE MONUMENT AGREES WITH BOTH WITNESSES. ACCEPTED THE HARRISON AS THE CORNER LOCATION. SET 4 NEW TIES AND MEASURED TO THE EXISTING WITNESSES.



(INDICATE CORNER BY "X")

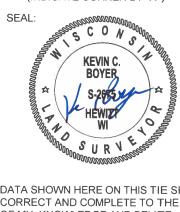

DATA SHOWN HERE ON THIS TIE SHEET IS CORRECT AND COMPLETE TO THE BEST OF MY KNOWLEDGE AND BELIEF.


PROFESSIONAL LAND SURVEYOR 3/2070

-TIE SKETCH

NOTE: THE CORNER LANDS ON THE CENTERLINE OF EMBER AVE. AND 3.4'± WEST OF 10TH AVE. CENTERLINE.



- SET 3/4" x 18" IRON REBAR, 1.50#/FT
- FOUND HARRISON MONUMENT
- VINYL "T" POST
- WITNESS TREE

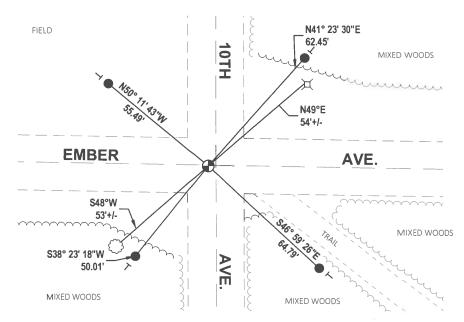

ADAMS COUNTY	CORNER NO	2U9
	SECTION _	22
Survey Monument Record		16
TYPE OF MONUMENT: 30" HARRISON	_	
STATE PLANE COORDINATES: N	RANGE _	6
ELEVATION — M.S.L. DATUM;		۱ ٦
THETA ANGLE:		.]
FIELD BOOK: PAGE		7
		-
DAGIO FOR MONITAGENTE Y OCCUPANT		
BASIS FOR MONUMENT LOCATION		İ
(Use reverse side if necessary)	X-i-L-i-	ال
Show info such as: History of corner, with reference to Vol. nd pg, dates, surveyor; exact description of monument replaced; f location computed, by taped or EDM traverse; landowner emarks, etc.	LOCATION (Indicated by 'X')	
Excavated area with a backhoe. Found	STRIPPING ANTHONY B.	
charcoal pit. Monumented same. Location	HIN SOUND	11/1/2
verified by a traverse of the entire section.	ANTHONY B.	
	KIEDROWSKI S-878	
	S-878 Wisconsin Rapids,	~ E
Everything O.k. 10-18-75 65-0.11.	Wis.	0
COR OK 10/16/80 KU-RN	1,	7.34
	SURV	in a contract of the contract
ALC OH 6-26-85 GR-SS	A11111111111	
ALL OK 1-30-90 GZ		
UK 1/31/35 CK -JG	ERTIFIED CORRECT:	
2-New TIES, 2-16-00, J6-55	egistered Land Surveyor	and a
ALL OK 2-22-05-JG 172-10 382-05-JG	ATE: 3/39/73	ح
146-70 35 BR		· · · · · · · · · · · · · · · · · · ·
TIE SKETCH_		
Show at least four ties)		
\bigcap		
TOTOP SIEN ROAD M	Agher K. CARLSON 1	200
	3/4 Roo	708
	34 Roo 46.75	
So So	E COR. AT TOP BOX SP 75	
2125 TX ELEC	c. Box 5775	
54.25 TX ELEC	NEMBER AVE.	
70'	2	
TWIN 16" 52.10		
W. PINE		
	KEN CARLSON I	988
	BLACK OAK - BARA	SPIKE
24 DAY 10	STOR TIDE / ST	

TO A BECO COLLECTORY	8 14
ADAMS COUNTY	CORNER NO. 249
Survey Monument Record	SECTION22
TYPE OF MONUMENT: 30" HARRISON	TOWN
STATE PLANE COORDINATES: N	RANGE6
<u>E</u>	ļ
ELEVATION — M.S.L. DATUM:	
THETA ANGLE: PAGE	
THOI -	
	l N
BASIS FOR MONUMENT LOCATION	
(Use reverse side if necessary)	
Show info such as: History of corner, with reference to Vol. and pg, dates, surveyor; exact description of monument replaced; if location computed, by taped or EDM traverse; landowner remarks, etc.	LOCATION (Indicated by 'X') EAL:
Excavated area with a backhoe. Found	ANTHONY B. KIEDROWSKI S-878 Wisconsin Rapids.
charcoal pit. Monumented same. Location verified by a traverse of the entire section.	
of the control of the charte secution,	ANTHONY B.
	KIEDROWSKI S-878
Every thing O.K. 10-18-75 85-0,0%	Wisconsin Rapids.
COR OK 10/16/80 KU-RN	\$71.
	SURVATION
ALC OH 6-26-85 GR-SS	The state of the s
ALC OK 6-26-85 GR-SS 8-8-88 Kin Carlyn	·
s s s por CANAM	CERTIFIED CORRECT:
	egistered Land Surveyor
	ATE: 9/39/12
THE CULTURAL	
TIE SKETCH	•
(Show at least four ties)	
	21.2 2" 2 2 1
STOP SIEN	• 3/4" x 24" Rod / Carlbin
RORD M	cap
	, and the second
A significant and the sign	Ka
S ₃ 2	
	nember Ave.
•	
	2
un 22	Commonl
	or ther ewe
for a	10" OAN
	/ TO OAK

REVISED 1972

		·		
		·		
	·			

			•	
		,		