16 *TOWN*

06 ADAMS COUNTY COUNTY CORNER NO: 90 ROMPORTOL ID: 41606230020

PUBLIC LAND SURVEY MONUMENT RECORD

HARRISON TYPE OF MONUMENT: ADAMS COUNTY COORDINATES, NAD 83 (2007)

N. 175239.636

E. 549722.366


ELEVATION-DATUM - — —

FIELD WORK DATE:___ 12/09/2020

BASIS FOR MONUMENT LOCATION

1979 - PLS 1321 RAN EDM/T16 TRAVERSE OF SECTION 23, T16N, R6E. FOUND A 3/4" IRON ROD SET BY DAVID CLARK DEC. 27, 1971. THIS ROD FIT VERY WELL WITH SECTION COMPOSITE AND ORIGINAL GOVERNMENT SURVEY NOTES. USED THIS ROD FOR THE SOUTH QUARTER AND MONUMENTED SAME WITH HARRISON MONUMENT JULY 11, 1979.

2020 - PLS 2675 FOUND HARRISON FLUSH WITH THE GROUND AND 2 WITNESSES. THIS MONUMENT AGREES WITH BOTH WITNESSES. ACCEPTED THE HARRISON AS THE CORNER LOCATION. SET 4 NEW TIES AND MEASURED TO THE WITNESSES.

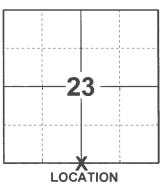

(INDICATE CORNER BY "X")



DATA SHOWN HERE ON THIS TIE SHEET IS CORRECT AND COMPLETE TO THE BEST OF MY KNOWLEDGE AND BELIEF.


PROFESSIONAL LAND SURVEYOR

12021

-TIE SKETCH



- SET 3/4" x 18" IRON REBAR, 1,50#/FT
- FOUND HARRISON MONUMENT
- VINYL "T" POST
- WITNESS TREE

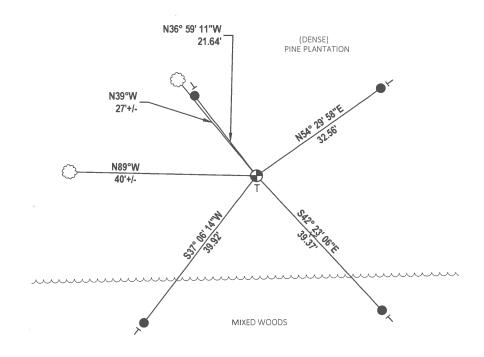

Government Land Corner Certificate		
AdamsCounty	CORNER NO	90
TYPE OF MONUMENT: 30" Harrison	SECTION _	23
STATE PLANE COORDINATES: N	TOWN _	16
E	RANGE _	6
ELEVATION — M.S.L. DATUM:		٦
THETA ANGLE:		
PAGEPAGE		4
	2 3 -	⊢ NJ
BASIS FOR MONUMENT LOCATION		114
Show info such as: History of corner, with reference to Vol.	4	İ
and pg., dates, surveyor; exact description of monument	LOCATION	
replaced; if location computed, by taped or EDM traverse; landowner remarks, etc. (Use reverse side if necessary) SEAL	(Indicated by 'X')	
Ran EDM/T16 traverse of Section 23, \$\forall 16N, R6E.	: 	-*
	INSCONS	19991
Found 3/4" iron rod set by David Clark Dec. 27, 1971. This rod fit very well with section composite and	A Comment of the Comm	(V"4)
priginal government survey notes.	JAMES R. GROTHMAN No. S-1321 Portage, Wisconsin A SHOWN HERE ON THE ON THE PROPERTY OF THE PRO	
	GROTHMAN No. S-1321	
Used this rod for the South Quarter and monumented same with Harrison monument July 11, 1973.	Portage,	j ž
with natition monument only ii, 15/2.	Wisconsin	18 F
	NO SURV	
	A STANSON OF THE PARTY OF THE P	
DAT	A SHOWN HERE ON	on a factor for
CER	TIFIED CORRECT:	<i>-</i>
Regis	tered Land Surveyor	Mma
DAT	97/10/	9
TIE SKETCH	re/UI	214
Show at least four ties, also fence lines, roads, topo, size	ANNUL PING	=5 14
and type of witness trees' and if off road - best way to arrive at corner.	4	
SURVEY MARKER SIGN 4"BIK CAN		Mammamm
Note: All ties 8'+ Surrent	120	
to trees are to	8	
PK nails 7HIC	A	· H
	NE STERRE LAY.	ING DOWN
339,85		-x
W 5	\$ 80- 52.C	12. V2, J
MAINTENANCE RECORD		SIGN SON
Date Init. Remarks 27" & RED CARE/BT	WIND STORES	DAKED S
10/20/80 KU-SK COR OK STRIK OOK	05 O TEE	Princi BT
10-31-85 MB-SS OK DND SIGN "55.00 /	GONE SONE	
1-30-90 GR OK FACING BAST	TO FILE	r e e
1-31-956-CR 1-CONE 1-NEW	PINES	
2-21-00 55 2 NOW TIES 4-5-05 JG ALL DK	1 7	
1-14-10 C- OK		

REVISED 1977

. **X**

and the second of the second o