

29
SECTION

16
TOWN

06
RANGE

ADAMS COUNTY

COUNTY CORNER NO: 104

ROMPORTOL ID: 41606290020

PUBLIC LAND SURVEY MONUMENT RECORD

TYPE OF MONUMENT: HARRISON
ADAMS COUNTY COORDINATES, NAD 83 (2007)

N. 169949.526

E. 533895.660


ELEVATION- DATUM

FIELD WORK DATE: 11/24/2020

BASIS FOR MONUMENT LOCATION

1975 - PLS 878 EXCAVATION WITH BACKHOE AFTER TRAVERSE OF SECTIONS 28, 29, AND 30 TO DETERMINE SEARCH AREAS. FOUND 6"x6"x31" CUT SANDSTONE MONUMENT IN REMNANTS OF ANCIENT FENCE LINE EAST AND WEST AND ON THE EXTENSION OF AN ANCIENT FENCE TO THE SOUTH. LOWERED STONE AND SET HARRISON ABOVE. WITNESSED BY FRED ALLEN, LAND OWNER TO THE NORTH.


2020 - PLS 2675 FOUND HARRISON 6"± ABOVE THE GROUND AND 1 TIE. THE MONUMENT AGREES WITH THE TIE. ACCEPTED THE HARRISON AS THE CORNER LOCATION. SET 2 NEW TIES, MEASURED TO A FOUND PROPERTY IRON, AND THE EXISTING TIE.

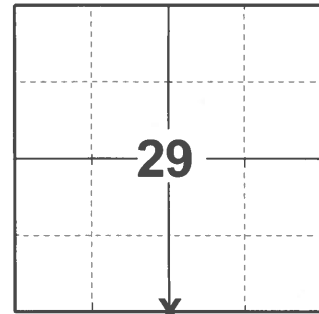

LOCATION

(INDICATE CORNER BY "X")

SEAL:

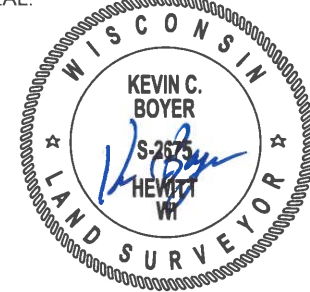



DATA SHOWN HERE ON THIS TIE SHEET IS CORRECT AND COMPLETE TO THE BEST OF MY KNOWLEDGE AND BELIEF.

PROFESSIONAL LAND SURVEYOR

DATE 12/3/2020

TIE SKETCH

NOTE: THE CORNER LANDS 73'± EAST OF 11TH DR. CENTERLINE.

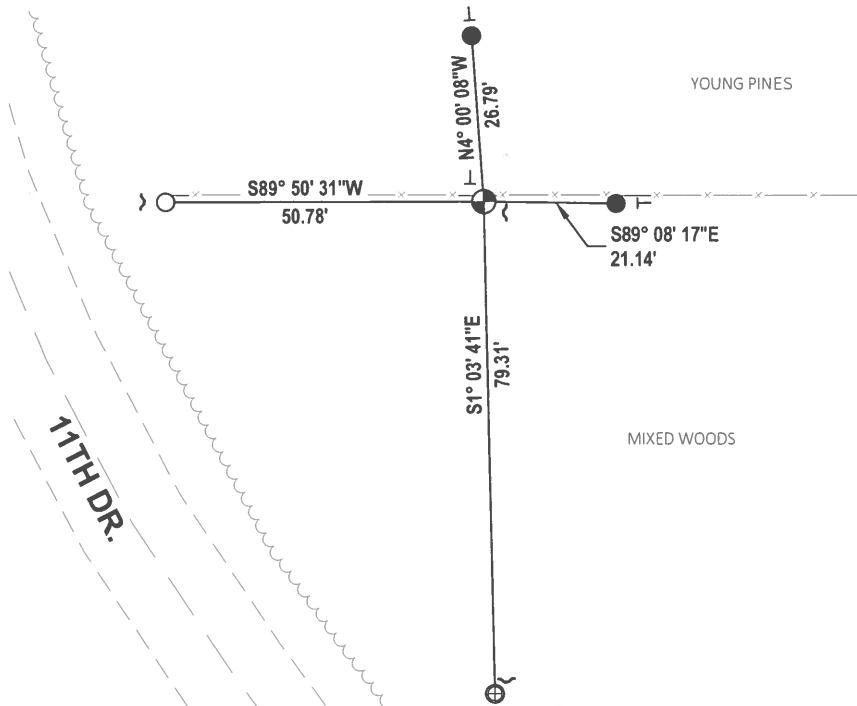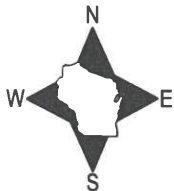

- SET 3/4" x 18" IRON REBAR, 1.50#/FT
- FOUND 3/4" IRON ROD
- ⊕ FOUND 1.00" O.D. IRON PIPE
- ⊕ FOUND HARRISON MONUMENT
- ┘ STEEL FENCE POST
- └ VINYL "T" POST

ADAMS COUNTY

Survey Monument Record

TYPE OF MONUMENT: STANDARD HARRISON

STATE PLANE COORDINATES: N _____

E _____

ELEVATION — M.S.L. DATUM: _____

THETA ANGLE: _____


FIELD BOOK: _____ PAGE _____

CORNER NO. 898 96

SECTION 29

TOWN 16 N

RANGE 6 E

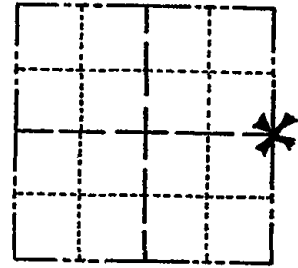

LOCATION
(Indicated by 'X')

SEAL:



BASIS FOR MONUMENT LOCATION

(Use reverse side if necessary)

Show info such as: History of corner, with reference to Vol. and pg, dates, surveyor; exact description of monument replaced; if location computed, by taped or EDM traverse; landowner remarks, etc.

Ran EDM/transit traverse around Sections 29 and 30 to determine search areas.

Could find no evidence of the original corner or any remonumentation.

Set corner equidistant and online between adjacent Section corners.

COR OK 10/17/80 KU-SK
OK 1-30-90 GR
ALL OK 1-9-95 JG-BS
1 GONE - 1 NEW 2-17-00 SS
1-NEW, 2-25-05 - JG
1-15-10 SS

CERTIFIED CORRECT:

Dale C. Hagen
Registered Land Surveyor
DATE: December 2, 1975

SUBSTATION HAS BEEN REMOVED

TIE SKETCH

(Show at least four ties)

