06 RANGE ADAMS COUNTY COUNTY COUNTY CORNER NO: 98

ROMPORTOL ID: 41606272000

PUBLIC LAND SURVEY MONUMENT RECORD

TYPE OF MONUMENT:_

1-1/4" IRON ROD

ADAMS COUNTY COORDINATES, NAD 83 (2007)

N. 172582.708

E. 547091.905

ELEVATION- - --- DATUM


FIELD WORK DATE:___ 11/19/2020

BASIS FOR MONUMENT LOCATION

1976 - PLS 878 EXCAVATED WITH BACKHOE. FOUND 8"X10"X12" SANDSTONE. LOWERED STONE AND SET HARRISON ON TOP. STONE CALLED FOR BY M.C. SMITH, MAY 1911, 1/138.

2001 - PLS UNKNOWN SET 1-1/4" IRON ROD IN PLACE OF HARRISON, RETIED.

2020 - PLS 2675 FOUND 1-1/4" IRON ROD 4"± BELOW THE ROAD SURFACE AND DID NOT RECOVER ANY EXISTING TIES OR WITNESSES. ACCEPTED 1-1/4" IRON ROD AS THE BEST AVAILABLE EVIDENCE OF THE CORNER LOCATION AND SET 4 NEW TIES.

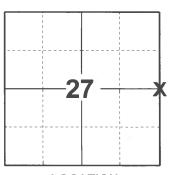

LOCATION

(INDICATE CORNER BY "X")




DATA SHOWN HERE ON THIS TIE SHEET IS CORRECT AND COMPLETE TO THE BEST OF MY KNOWLEDGE AND BELIEF.

PROFESSIONAL LAND SURVEYOR

-TIE SKETCH

NOTE: THE CORNER LANDS 3'± NORTH OF CTH "A" CENTERLINE.



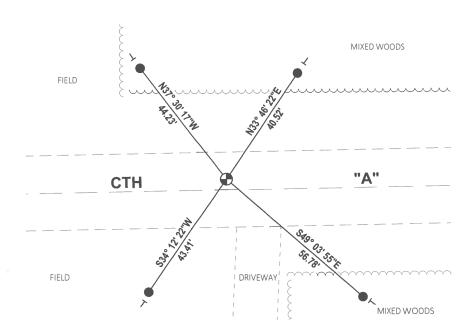

- SET 3/4" x 18" IRON REBAR, 1.50#/FT
 - FOUND 1-1/4" IRON ROD MONUMENT
 - VINYL "T" POST

ADAMS COUNTY

Survey Monument Record

TYPE OF MONUMENT: Harrison standard /1/4" Roo

STATE PLANE COORDINATES: N. E.

ELEVATION — M.S.L. DATUM: ___

THETA ANGLE: _

FIELD BOOK: 40 PAGE .

BASIS FOR MONUMENT LOCATION

(Use reverse side if necessary)

Show info such as: History of corner, with reference to Vol. and pg, dates, surveyor; exact description of monument replaced; if location computed, by taped or EDM traverse; landowner remarks, etc.

Excavated with backhoe. Found 8x10x12" sandstone .Lowered stone and set Harrison on top. Stone called for by M.C.Smithm, May, 1911, 1/138.

MON. BEEPS TIES OK 10/17/80 KU-SK

ALL OK 7-15-85 D.K.

OK 1-30-90 GR OK 1/31/95 CR-JG


2-NEW TIES 8-29-98 - JG OK - 2-17-00 55 SET 114" ROD, RETIE 10-29-01 ALL OK 2-24-05-JG

CORNER NO.

SECTION

TOWN

RANGE

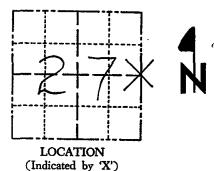

SEAL:



CERTIFIED CORRECT:

Registered Land Surveyor

DATE: 4/29/76

