TOWN

TYPE OF MONUMENT:

## **D6** ADAMS COUNTY

COUNTY CORNER NO: 100

ROMPORTOL ID: 41606252000

## PUBLIC LAND SURVEY MONUMENT RECORD

HARRISON (BROKEN-TOP)


ADAMS COUNTY COORDINATES, NAD 83 (2007) N. **172617.832** E. <u>557699.544</u> **ELEVATION-**DATUM 11/16/2017 FIELD WORK DATE:

## BASIS FOR MONUMENT LOCATION


1974 - PLS 776 MACHINE EXCAVATED AND FOUND NOTHING. (RECORDED IN C.S.M. VOL. 1, PG. 71). SET A HARRISON MONUMENT AT THE CALCULATED CORNER LOCATION AND TIED OUT.

1999 - PLS 1397 EXISTING MONUMENT WAS FOUND AT THE CORNER LOCATION. MONUMENT WAS REMOVED AND RAISED DUE TO RECONSTRUCTION OF C.T.H. B. CORNER WAS RE-TIED.

2017 - PLS 2994 FOUND A HARRISON MONUMENT WITH A BROKEN-TOP 6" BELOW THE ROAD SURFACE, 1 ADDITIONAL PROPERTY IRON AND 2 WITNESS TREES. THE MONUMENT AGREES WITH THE WITNESS TREES. ACCEPTED THE HARRISON MONUMENT WITH A BROKEN-TOP AS THE CORNER LOCATION. SET 3 NEW TIES AND MEASURED TO THE TIES, PROPERTY IRON AND WITNESS TREES.

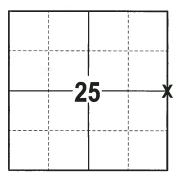

LOCATION (INDICATE CORNER BY "X")

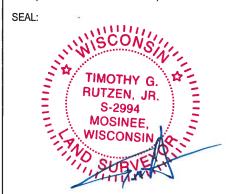

DATA SHOWN HERE ON THIS TIE SHEET IS CORRECT AND COMPLETE TO THE BEST OF MY KNOWLEDGE AND BELIEF

PROFESSIONAL LAND SURVEYOR

12-4-17 DATE

## - TIE SKETCH


NOTE: THE CORNER FALLS 0.5'± EAST OF THE CENTERLINE OF CTH B AND 150'± NORTH OF THE CENTERLINE OF EMBER DR.



- 3/4" x 18" IRON REBAR SET, 1.50#/FT 3/4" IRON ROD FOUND
- 🕀 HARRISON (BROKEN-TOP) FOUND

✓ STEEL FENCE POST VINYL "T" POST

WITNESS TREE FOUND

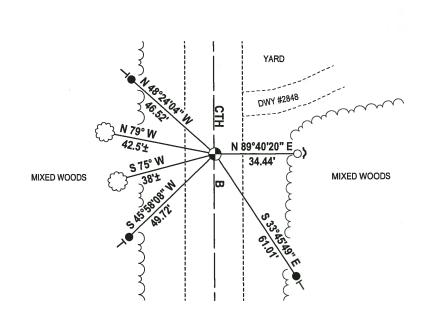


	•	
ADAMS COUNTY	CORNER NO.	
Survey Monument Record	SECTION	<u> 25</u>
TYPE OF MONUMENT: HARRISON	TOWN	16
STATE PLANE COORDINATES: N	RANGE	6
E		
ELEVATION — M.S.L. DATUM:		
THETA ANGLE:		4
FIELD BOOK: ADAMS PAGE FILE		-* NI
	_	IN
BASIS FOR MONUMENT LOCATION		·i
(Use reverse side if necessary)	<u> </u>	
Show info such as: History of corner, with reference to Vol.	LOCATION (Indicated by 'X')	
and pg, dates, surveyor; exact description of monument replaced; if location computed, by taped or EDM traverse; landowner remarks, etc.	SEAL:	
TIES ARE TO 20# SPIKES	AND STREET STREET	Do.
	Marin Miscold	LAND.
MACHINE EXCAUATED - FOUND NOTHING. RECORDED IN C.S.M. VOL.1, PG71	<b>S</b> /	1 5
RECORDED IN C.S.M. VOL.1, PG71	HERMAN S. HOLZMILLER	T
JIE MEASUREMENTS ARE HORIZONTAL	BARASOO,	<b>`</b>
	WISCONSIN	
	RUSSECULO SURV EET 7-26-99:	1,338
SEE	RUSSECHIOSURY	769 68 A
THE SME	SET 1-26- Printings	.•
COR. O.K. 10-14-75 55		
MON. BEEPS TIES OK 10/11/80 XU-SK	CERTIFIED CORRECT:	•
ALL OX 7-15-85 D.K.	German Hofm	De
04 1-30-90 GP	Registered Land Surveyor 5-	776
OK 1-30-90 GR OK 4-17-90 KEN CARLSON	DATE: 12-16-74	
TIE SKETCH ALL OK 1/23/95 JG-GR		
COLUMN THE SHEET OR SETE ATTACHED THE SHEET	RUSSELL 7-26-99 JG-	9-7-00
1-60NE 3-1-05 - JG  OK 1-14-10 SS	,	
1	w 0,005	4
WOODS	CONE'	
£	) 124 JACK PINE OF	N
12" JACK PINE 07 N 48.20 E	1 - 1 W De -1	E 14
42.60	CSM VI, PG71	
558°E	·	
7.8		***
	S" JACK PINE	
	S. Jack I. Cools &	,
	, , /0 <i>T</i>	
	* *	* *

Existing Monument was found in place. Monument was removed and raised due to reconstruction of C.T.H. "B". All tie measurements are horizontal measurements unless noted otherwise.

528 CORNER NO. 25 SECTION 16N TOWN 6E RANGE

(100)

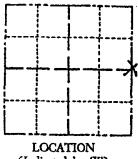

(Indicated by 'X')

DENNIS J. ☆ RUSSELL S-1397 MADISON,

Management SUH Supering Superi

SEAL:

TIE SKETCH

remarks, etc.

(Show at least four ties)

ALL MEASUREMENTS ARE HORIZONTAL.

