TOWN

# 06 ADAMS COUNTY CORNER NO: 109 ROMPORTOL ID: 41606270000

## PUBLIC LAND SURVEY MONUMENT RECORD

**HARRISON** TYPE OF MONUMENT: ADAMS COUNTY COORDINATES, NAD 83 (2007) N. 169931.393 E. 547107.127 ELEVATION-DATUM\_\_ - — — 11/19/2020 FIELD WORK DATE:\_\_\_

### BASIS FOR MONUMENT LOCATION

1976 - PLS 878 EXCAVATED WITH BACKHOE, FOUND CHARCOAL DEPOSIT, NOTHING ELSE. ACCEPTED AS CORNER AFTER ANALYZING AN EDM TRAVERSE OF THE SECTION. NO RESURVEYS ON RECORD.

2020 - PLS 2675 FOUND HARRISON FLUSH WITH THE ROAD SURFACE AND 1 WITNESS TREE. THE MONUMENT AGREES WITH THE WITNESS TREE. ACCEPTED THE HARRISON AS THE CORNER LOCATION. SET 4 NEW TIES AND MEASURED TO THE EXISTING WITNESS TREE.



(INDICATE CORNER BY "X")




DATA SHOWN HERE ON THIS TIE SHEET IS CORRECT AND COMPLETE TO THE BEST OF MY KNOWLEDGE AND BELIEF.

PROFESSIONAL LAND SURVEYOR

#### -TIE SKETCH

NOTE: THE CORNER LANDS 0.5'± NORTH OF EVERGREEN AVE. CENTERLINE.



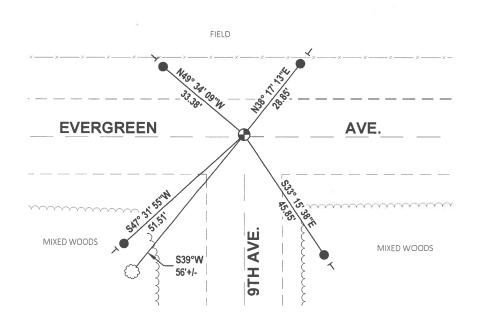

SET 3/4" x 18" IRON REBAR, 1.50#/FT

FOUND HARRISON MONUMENT

VINYL "T" POST

WITNESS TREE

## ADAMS COUNTY

## Survey Monument Record

TYPE OF MONUMENT: HARRISON STATE PLANE COORDINATES: N. ELEVATION - M.S.L. DATUM:


## BASIS FOR MONUMENT LOCATION

(Use reverse side if necessary)


Show info such as: History of corner, with reference to Vol. and pg, dates, surveyor; exact description of monument replaced; if location computed, by taped or EDM traverse; landowner

Excavated with backhoe, found charcoal deposit, nothing elze. Accepted as corner after analyzing an EDM traverse of the section. No resurveys on record.

COR OK 10/17/80 KU-SK ALL OK 7-15-85 DK ALL OK 2-12-90 KZ-GR OK 1/31/95 CR-19 OK 2-17-00 55 ALL OK 2-24-05-JG 1 NOW 174-10 55

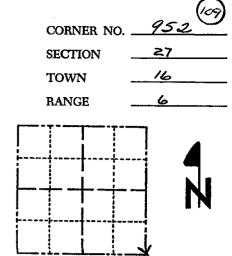

SEAL:

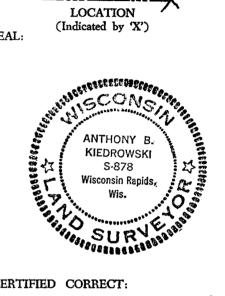

LOCATION

CERTIFIED CORRECT:

Registered Land Surveyor
DATE: 6/1/1976 DATE: \_

#### TIE SKETCH

REVISED 1974

(Show at least four ties)

