TOWN

D6 RANGE ADAMS COUNTY C

PUBLIC LAND SURVEY MONUMENT RECORD

HARRISON TYPE OF MONUMENT: ADAMS COUNTY COORDINATES, NAD 83 (2007)

N. 167276.570

E. 547131.486


ELEVATION-DATUM - ----

FIELD WORK DATE: 12/10/2020


BASIS FOR MONUMENT LOCATION

1978 - PLS 922 RESEARCHED ADAMS COUNTY SURVEY RECORDS AND FOUND TO RESURVEYS ON FILE WHICH PERTAINED TO THIS CORNER. NO REMAINING EVIDENCE OF ORIGINAL CORNER OR BEARING TREES. FOUND AN 1-1/2" IRON PIPE AND ACCEPTED AS BEST AVAILABLE EVIDENCE AND MONUMENTED SAME.

2020 - PLS 2675 FOUND HARRISON 2"± ABOVE THE GROUND AND 4 WITNESS TREES. THE MONUMENT AGREES WITH ALL 4 WITNESS TREES. ACCEPTED THE HARRISON AS THE CORNER LOCATION. SET 4 NEW TIES AND MEASURED TO THE EXISTING WITNESS TREES.

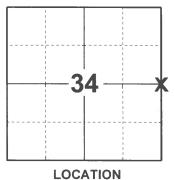

(INDICATE CORNER BY "X")

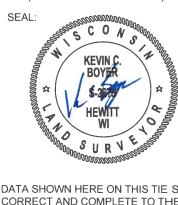

DATA SHOWN HERE ON THIS TIE SHEET IS CORRECT AND COMPLETE TO THE BEST OF MY KNOWLEDGE AND BELIEF.


PROFESSIONAL LAND SURVEYOR

DATE

-TIE SKETCH



- SET 3/4" x 18" IRON REBAR, 1.50#/FT
- O FOUND 4" WOOD POST
- FOUND HARRISON MONUMENT
- VINYL "T" POST
- WITNESS TREE

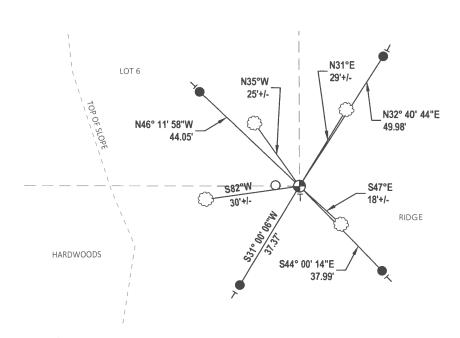

Government Land Corner Certificate


ADAMS	County	,
TYPE OF MONUMENT:		,,
STATE PLANE COORDINATE		
	E	
ELEVATION - M.S.L. DATU	IM:	
THETA ANGLE:		
FIELD BOOK:	PAGE	
DRAWN BY: SQUIRES		

BASIS FOR MONUMENT LOCATION


Show info such as: History of corner, with reference to Vol. and pg., dates, surveyor; exact description of monument replaced; if location computed, by taped or EDM traverse; landowner remarks, etc. (Use reverse side if necessary)

RESEARCHED FLAMS COUNTY SURVEY
RECORDS & FOUND NO RESURVEYS
ON FILE WHICH PERTAINED TO THIS
CORNER. NO REMAINING EVIDENCE
OF ORIGINAL CORNER OR B.T.'S
FOUND AN 1/2" IRON PIPE AND
ACCEPTED AS BEST AVAILABLE
EVIDENCE, & MONUMENTED SAME.

CORNER NO	118
SECTION _	34
TOWN _	
BANCE	6 E

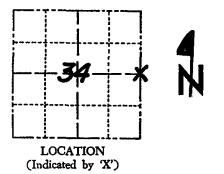

SEAL:

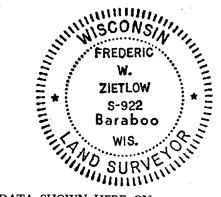

DATA SHOWN HERE ON CERTIFIED CORRECT:

Registered Land Surveyor

DATE: JUNE 30,1978

TIE SKETCH

Show at least four ties, also fence lines, roads, topo, size and type of witness trees' and if off road - best way to arrive at corner.

MAINTENANCE RECORD

MIMITIE VIETCE TECOTED		
Date	Init.	Remarks
10/20/80	KU-SK	COR OK
10.31.85	mB-55	OK
2-7-90	GR	OK
2-8-95	JG	OK
2-17.60	\$5	I NEW TIE
4.5-05	56	ALL OK

LOT 4

DIO" RED
OAK | BT

OAK | SHINER IN

OAK | SHINER IN

OAK | ST

PK. & SHINER IN

OAK | OAK | BT

OAK | OAK | BT

OAK | OAK | BT

OAK OAK | BT

OAK OAK | BT

OAK OAK | BT

