SECTION

OB ADAMS COUNTY

COUNTY CORNER NO: 120

ROMPORTOL ID: 41606362000

PUBLIC LAND SURVEY MONUMENT RECORD

TYPE OF MONUMENT: 1-1/4" O.D. IRON PIPE IN CONCRETE ADAMS COUNTY COORDINATES, NAD 83 (2007)

N. **167342.958**

E. 557715.724


ELEVATION- ----DATUM — — —

FIELD WORK DATE: 11/16/2017


BASIS FOR MONUMENT LOCATION

1975 - PLS 1103 RAN EDM/TRANSIT TRAVERSE AROUND SECTION 36-16-6 AND SECTION 1-15-6 TO DETERMINE SEARCH AREAS. FOUND EXISTING CONCRETE MONUMENT WITH A BRASS CAP WITH INCORRECT CORNER MARKINGS ON TOP, SET BY PAST COUNTY SURVEYOR PHILLIPS. ACCEPTED SAME AS CORNER AND TIED OUT.

2017 - PLS 2994 FOUND A 1-1/4" O.D. IRON PIPE IN CONCRETE 6" BELOW THE GROUND SURFACE. 2 TIES AND 1 WITNESS TREE. THE MONUMENT AGREES WITH THE EXISTING TIES AND WITNESS TREE. ACCEPTED THE 1-1/4" O.D. IRON PIPE IN CONCRETE AS THE CORNER LOCATION. SET 2 NEW TIES AND MEASURED TO THE TIES AND WITNESS TREE.

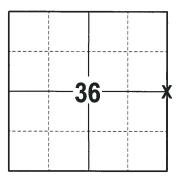

LOCATION (INDICATE CORNER BY "X")

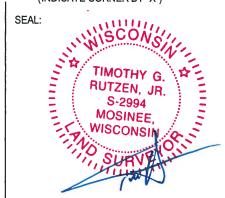

DATA SHOWN HERE ON THIS TIE SHEET IS CORRECT AND COMPLETE TO THE BEST OF MY KNOWLEDGE AND BELIEF.

PROFESSIONAL LAND SURVEYOR


- TIE SKETCH

NOTE: THE CORNER FALLS 26'± WEST OF THE CENTERLINE OF CTH B.



- 3/4" x 18" IRON REBAR SET, 1.50#/FT
- O 3/4" IRON ROD FOUND
- ⊕ 1-1/4" O.D. IROD PIPE FOUND
- 1-1/4" O.D. IRON PIPE IN CONCRETE FOUND
- H VINYL "T" POST

WITNESS TREE FOUND

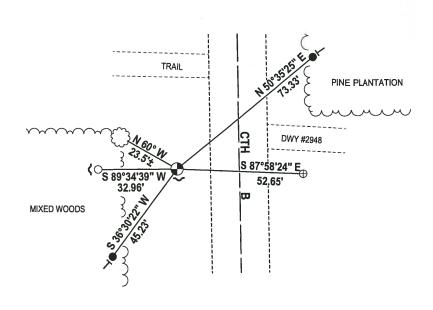

CORNER NO. -ADAMS COUNTY 36 SECTION Survey Monument Record I" PIPE TOWN TYPE OF MONUMENT: Existing Cone. Monument with Brees Cap RANGE STATE PLANE COORDINATES: N_ E. ELEVATION - M.S.L. DATUM: _ THETA ANGLE: ___ FIELD BOOK: _____ _____ PAGE _ BASIS FOR MONUMENT LOCATION (Use reverse side if necessary) LOCATION Show info such as: History of corner, with reference to Vol. and pg, dates, surveyor; exact description of monument replaced; if location computed, by taped or EDM traverse; landowner (Indicated by 'X') SEAL: remarks, etc. Ran EDM/transit traverse around Section 36-16-6 and Section 1-15-6 to determine search areas. Found existing concrete monument with brass cap with incorrect corner markings on top, of type DALE C. HAGEN S-1103 set by past County Surveyor Phillips. Wisconsin Rapids, Accepted same as corner and tied out. COR OK 10/20/80 KU SK ALL OK 7-15-85 DK. ALL OK 2-12-90 KZ-GR ALL OK 1/23/95 JG-GR 1-NEW 9-7-00, JG 1- NEW 3-1-05-56 TIE SKETCH GONE (Show at least four ties) NOTE: Ties in trees to nail in disc. NEW NAU 8-81k.00k, NOTE: Top marked DND SIGN

I" I P. SET

IRON ROD

NEW NAIL

KITWIN Oak /