33 SECTION

OB ADAMS COUNTY

COUNTY CORNER NO: 126

ROMPORTOL ID: 41606330020


PUBLIC LAND SURVEY MONUMENT RECORD

TYPE OF MONUMENT: **HARRISON** ADAMS COUNTY COORDINATES, NAD 83 (2007) N. **164692.761** E. 539215.965 ELEVATION- - - -DATUM -- --- -FIELD WORK DATE: 11/15/2017


BASIS FOR MONUMENT LOCATION

1975 - PLS 922 FOUND A 1" IRON PIPE IN THE REMNANTS OF A EAST-WEST FENCE OFF OF A TREE LINE OCCUPATION LINE TO THE NORTH. NO RESURVEYS WERE FOUND IN COUNTY SURVEY RECORDS. SET A 30" HARRISON MONUMENT AT THE CORNER LOCATION AND TIED

2017 - PLS 2994 FOUND A HARRISON MONUMENT FLUSH WITH THE GROUND SURFACE. 1 TIE (UNSURE OF THE ORIGIN OF THE 1" O.D. IRON PIPE) AND 3 WITNESS TREES. THE MONUMENT AGREES WITH THE WITNESS TREES. ACCEPTED THE HARRISON MONUMENT AS THE CORNER LOCATION. SET 3 NEW TIES AND MEASURED TO THE TIES AND WITNESS TREES.

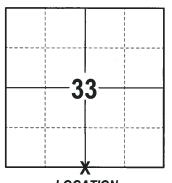

LOCATION (INDICATE CORNER BY "X")

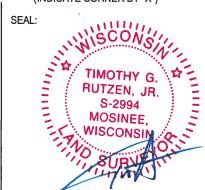

DATA SHOWN HERE ON THIS TIE SHEET IS CORRECT AND COMPLETE TO THE BEST OF MY KNOWLEDGE AND BELIEF.


PROFESSIONAL LAND SURVEYOR

12-4-17

- TIE SKETCH



 3/4" x 18" IRON REBAR SET, 1.50#/FT ○ 1" O.D. IROD PIPE FOUND HARRISON FOUND → VINYL "T" POST $\mathbb{P}^{\mathbb{N}}$ WITNESS TREE STUMP FOUND WITNESS TREE FOUND

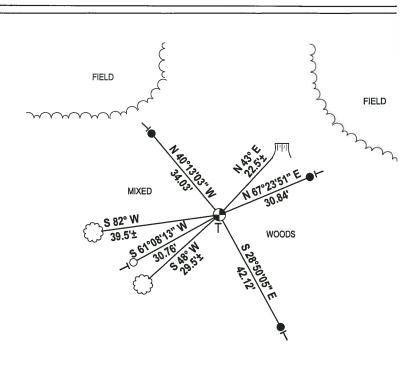

ADAMS COUNTY

Survey Monument Record

TYPE OF MONUMENT: 30" HARRISON MONUMENT


STATE PLANE COORDINATES: N_______

ELEVATION — M.S.L. DATUM: ______

THETA ANGLE: ______

FIELD BOOK: 429 ADAMS CO. PAGE _____ 36

CORNER NO.	
SECTION	33
TOWN	
RANGE	6

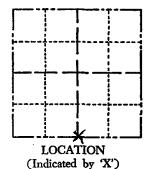

SEAL:

4 N

BASIS FOR MONUMENT LOCATION

(Use reverse side if necessary)

Show info such as: History of corner, with reference to Vol. and pg, dates, surveyor; exact description of monument replaced; if location computed, by taped or EDM traverse; landowner remarks, etc.

FOUND I TRON PIPE IN REMNANTS OF EAST-WEST FENCE OFF TREE LINE OCCUPATION LINE TO NORTH. NO RESURVEYS WERE FOUND IN COUNTY SURVEY RECORDS.

CORNER O.K. 11-2-76 RN-SS COR OK 10/17/80 KU-SK " 10-31-85 MB-SS ZNEW Z-12-90 KZ-GR ALL OK 1-9-95 JG-BS 1-GONE, 1-NEW, 12-06-00-JG ALL OK, 2-25-05-JG " " 3-22-10 SS ZIETLOW
S-922
Baraboo
WIS.

CERTIFIED CORRECT:

Freelen W. Zierton

Registered Land Surveyor

DATE: MAY 15, 1975

THE SKETCH Enter field drive from 10th Hoe or FROM EUGRGREEN DR.

(Show at least four ties)

DND SIGN '05"

BURE

CONN 96 DEAD

STAR

ISTAN

DND SIGN 05"

PARTS OF OLD FENCE

DND SIGN '05"

DND SIGN '0

N

<u>--</u> -

i.

CORNER NO. ADAMS COUNTY EE SECTION Survey Monument Record 16 TOWN TYPE OF MONUMENT: 30" HARRISON MONUMENT 6 RANGE STATE PLANE COORDINATES: N. ELEVATION - M.S.L. DATUM: . THETA ANGLE: . FIELD BOOK: 429 ADAMS CO. PACE BASIS FOR MONUMENT LOCATION (Use reverse side if necessary) LOCATION Show info such as: History of corner, with reference to Vol. (Indicated by 'X') and pg, dates, surveyor; exact description of monument replaced; if location computed, by taped or EDM traverse; landowner SEAL: FOUND I "IRON PIPE IN REMNANTS OF BAST - WEST FENCE OFF TREE LINE OCCUPATION LINE TO NORTH FREDERIC NO RESURVEYS WERE FOUND IN W. ZIETLOW COUNTY SURVEY RECORDS. S-922 Baraboo S2 49. CONNIA O. # 11 2 76 COP. OK 101.7/80 KU SK. 10 31 85 MB. 55 SNEW 2-12-90 KZ-GR sept 28'94 Ken Cer 1900 CERTIFIED CORRECT: $l\nu$. Registered Land Surveyor DATE: MAY 15, 1975 TIE SKETCH (Show at least four ties) STREE LINE

