SECTION

OF ADAMS COUNTY

COUNTY CORNER NO: 133

ROMPORTOL ID: 41706360000


PUBLIC LAND SURVEY MONUMENT RECORD

HARRISON TYPE OF MONUMENT: ADAMS COUNTY COORDINATES, NAD 83 (2007) N. **192510.349** E. 557685.427 DATUM --11/21/2017 FIELD WORK DATE:


BASIS FOR MONUMENT LOCATION

1973 - PLS 878 MADE MEASUREMENTS A MILE TO THE EAST, WEST AND SOUTH COMPARED DISTANCES TO ORIGINAL NOTES AND C&NW RAILROAD MAP. M.C. SMITH SAID THIS CORNER WAS MISSING IN 1910 AND HE DID NOT RE-SET THE CORNER. EXCAVATED CONSIDERABLE AREA WITH BACKHOE AND FOUND NO EVIDENCE OF CORNER.

2017 - PLS 2994 FOUND A HARRISON MONUMENT 10" BELOW THE ROAD SURFACE, 1 PROPERTY IRON USED AS A TIE AND 2 WITNESSES. THE MONUMENT AGREES WITH THE PROPERTY IRON AND WITNESSES. ACCEPTED THE HARRISON MONUMENT AS THE CORNER LOCATION. SET 3 NEW TIES AND MEASURED TO THE TIES AND WITNESSES.

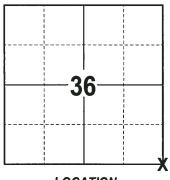

LOCATION (INDICATE CORNER BY "X")

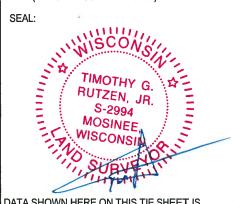

DATA SHOWN HERE ON THIS TIE SHEET IS CORRECT AND COMPLETE TO THE BEST OF MY KNOWLEDGE AND BELIEF.

PROFESSIONAL LAND SURVEYOR

12-21-17

- TIE SKETCH

NOTE 1: THE CORNER FALLS 10'± NORTH OF THE CENTERLINE OF EAGLE AVE.


NOTE 2: FOUND WITNESS, A NAIL WITH WASHER IN A FENCE POST N02°E, A DISTANCE 33.4'.



3/4" x 18" IRON REBAR SET, 1.50#/FT 1-1/4" O.D. IROD PIPE FOUND HARRISON FOUND

STEEL FENCE POST VINYL "T" POST

WITNESS TREE FOUND

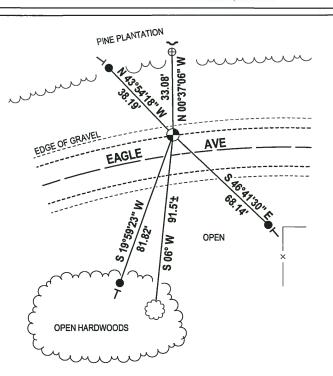

337 ADAMS COUNTY CORNER NO. _ SECTION Survey Monument Record TOWN TYPE OF MONUMENT: Harrison RANGE STATE PLANE COORDINATES: N. E. ELEVATION - M.S.L. DATUM: _ THETA ANGLE: . PAGE 122 FIELD BOOK: 108 BASIS FOR MONUMENT LOCATION (Use reverse side if necessary) LOCATION Show info such as: History of corner, with reference to Vol. and pg, dates, surveyor; exact description of monument replaced; if location computed, by taped or EDM traverse; landowner (Indicated by 'X') SEAL: Made maasuraments a mila HTLOS & TREW & TRES Compared with original notes ANTHONY B. and GENM IS IS OMAD. **KIEDROWSKI** M.C. Smith said this S-878 Wisconsin Rapids. 20 CONNEL WOS 6mg, 3 S, mg 1 20 Wis. That be did 、て Tezer ross excavated, considerable with backhor found nothing. CERTIFIED CORRECT: CORNER Registered Land Surveyor 0.6 2-22-77 **39-22-8**2 11 11-26-86 DATE: . 12-26-91 7025 TIE SKETCH OK, 12-14-01 - M.L (Show at least four ties) OK 1-24-07- J6 OK 01-17-12 MS COR. POST

REVISED 1972