SECTION

OT ADAMS COUNTY

COUNTY CORNER NO:__122 ROMPORTOL ID: 41707310020


PUBLIC LAND SURVEY MONUMENT RECORD

HARRISON TYPE OF MONUMENT: ADAMS COUNTY COORDINATES, NAD 83 (2007) N. **192508.949** E. 560030.767 ELEVATION-DATUM FIELD WORK DATE: 12/06/2017


BASIS FOR MONUMENT LOCATION

1976 - PLS 878 CALCULATED THE POSITION ON A STRAIGHT LINE AND PROPORTIONAL TO THE ORIGINAL NOTES. EXCAVATED WITH A BACKHOE AND DID NOT FIND ANYTHING. NO RESURVEYS OF RECORD. SET A HARRISON MONUMENT AT THE CALCULATED LOCATION AND TIED OUT. (CORNER WAS SET PRIOR TO MAY OF 1974 BUT RECORDS LOST IN A FIRE AND RE-TIED ON

2017 - PLS 2994 FOUND A HARRISON MONUMENT 2" BELOW THE ROAD SURFACE. DID NOT RECOVER ANY TIES OR WITNESSES. ACCEPTED THE HARRISON MONUMENT AS THE CORNER LOCATION. SET 4 NEW TIES AND MEASURED TO THE TIES.

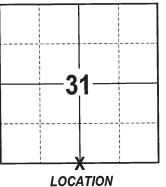

(INDICATE CORNER BY "X")

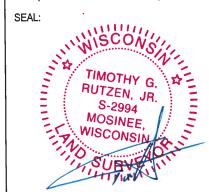


DATA SHOWN HERE ON THIS TIE SHEET IS CORRECT AND COMPLETE TO THE BEST OF MY KNOWLEDGE AND BELIEF.

PROFESSIONAL LAND SURVEYOR

- TIE SKETCH

NOTE: THE CORNER FALLS 3'± NORTH OF THE CENTERLINE OF EAGLE AVE AND 7'± EAST OF THE CENTERLINE OF 6TH DR



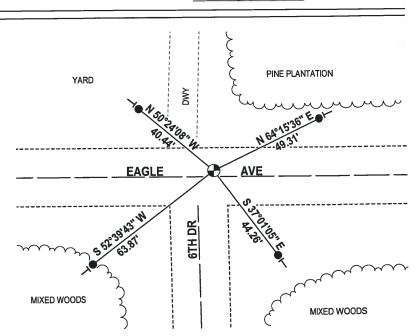

 3/4" x 18" IRON REBAR SET, 1.50#/FT HARRISON FOUND

→ VINYL "T" POST

ADAMS COUNTY

Survey Monument Record

TYPE OF MONUMENT: ____Harrison

STATE PLANE COORDINATES: N_____

ELEVATION — M.S.L. DATUM: _____

THETA ANGLE: _____
FIELD BOOK: ____37 ____ PAGE ___53

BASIS FOR MONUMENT LOCATION


(Use reverse side if necessary)

Show info such as: History of corner, with reference to Vol. and pg, dates, surveyor; exact description of monument replaced; if location computed, by taped or EDM traverse; landowner remarks, etc.

Set on a straight line and proportional to original notes. Excavated with backhoe but found nothing. No resurveys of record.

Set prior to May of 1974 but records lost in a fire. Re-tied 7/7/76

COR. OK	3.22.82	GR-55
,) //	11/25/86	ER
ZNEW	12-26-91	KZ-612
OK	12-10-96	2.2
OK	12-14-01	ML
OK	01-17-12	M5

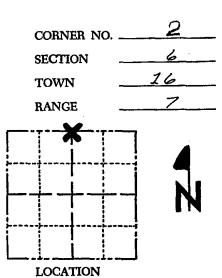

SEAL:



CERTIFIED CORRECT:

And Oz and OS J Color Color

Registered Land Surveyor

DATE: 7/5/77

TIE SKETCH

REVISED 1974

