

36
SECTION

17
TOWN

07
RANGE

ADAMS COUNTY

COUNTY CORNER NO: 132

ROMPORTOL ID: 41707360020

PUBLIC LAND SURVEY MONUMENT RECORD

TYPE OF MONUMENT: HARRISON
ADAMS COUNTY COORDINATES, NAD 83 (2007)

N. 192612.490

E. 586499.548


ELEVATION- DATUM

FIELD WORK DATE: 12/11/2017

BASIS FOR MONUMENT LOCATION

1976 - PLS 1103 RAN E.D.M./T2 TRAVERSE AROUND SECTIONS 1, 12, 11 AND PARTS OF ADJOINING SECTIONS TO DETERMINE THE SEARCH AREA FOR INVESTIGATION. COULD FIND NO EVIDENCE OF THE ORIGINAL CORNER OR ANY REMONUMENTATION. EXISTING DOWN FENCES DID NOT FIT PRO-RATION. SET THE CORNER BY SINGLE PROPORTIONATE MEASURE BETWEEN THE NORTHEAST AND NORTHWEST CORNERS OF SECTION 1. SET A HARRISON MONUMENT AT THE CORNER LOCATION AND TIED OUT.

2017 - PLS 2994 FOUND A HARRISON MONUMENT 4" BELOW THE GROUND SURFACE. ALL OF THE WITNESSES HAVE BEEN DESTROYED DUE TO RECENT LOGGING. ACCEPTED THE HARRISON MONUMENT AS THE CORNER LOCATION. SET 4 NEW TIES AND MEASURED TO THE TIES.

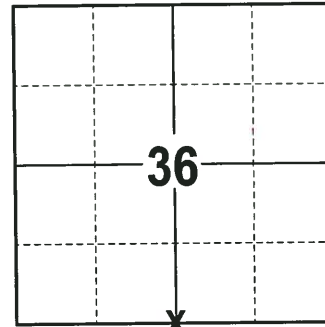

LOCATION
(INDICATE CORNER BY "X")

SEAL:





DATA SHOWN HERE ON THIS TIE SHEET IS CORRECT AND COMPLETE TO THE BEST OF MY KNOWLEDGE AND BELIEF.

PROFESSIONAL LAND SURVEYOR

DATE 12-21-17

- TIE SKETCH

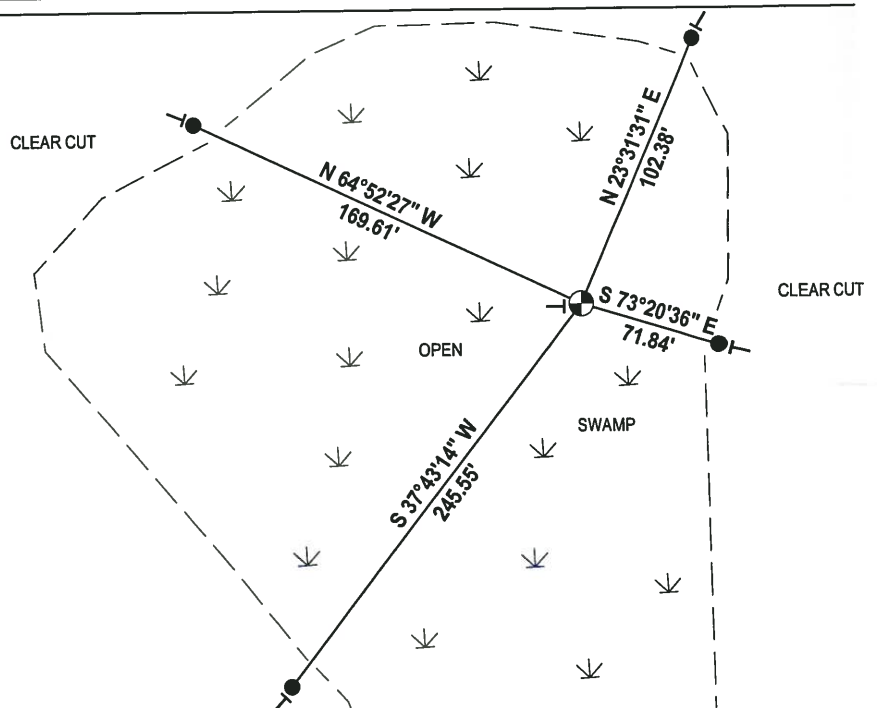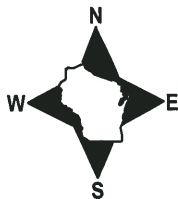


- 3/4" x 48" IRON REBAR SET, 1.50#/FT
- ⊕ HARRISON FOUND
- VINYL "T" POST

ADAMS COUNTY

Survey Monument Record

TYPE OF MONUMENT: HARRISON
STATE PLANE COORDINATES: N 43°53'39.7"
HAND HELD R W 89°36'26.6"
ELEVATION — M.S.L. DATUM: _____
THETA ANGLE: _____
FIELD BOOK: 34 PAGE 68

CORNER NO. 1071 (12)
SECTION 1
TOWN 16
RANGE 7

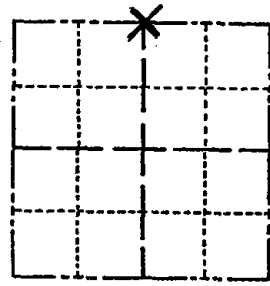

LOCATION
(Indicated by 'X')

SEAL:



BASIS FOR MONUMENT LOCATION

(Use reverse side if necessary)

Show info such as: History of corner, with reference to Vol. and pg, dates, surveyor; exact description of monument replaced; if location computed, by taped or EDM traverse; landowner remarks, etc.

Ran EDM/T2 traverse around Sections 1, 12, 11 and parts of adjoining sections to determine search area for investigation.

Could find no evidence of the original corner or any remonumentation. Existing down fences do not fit proration.


Set corner by single proportionate measure between the Northeast and Northwest corners of Section 1.

Corner set 11-2-76.

Cor OK 4-23-82 GR
" " 12-10-86 GR
" " 12-30-91 GR-JG
" " 12-10-96 SS

CERTIFIED CORRECT
Dale C Hagen
Registered Land Surveyor
DATE: 11-3-76

TIE SKETCH OK 3-4-02-GR OK, 12-4-01-JG 01-10-12 OK GPR
(Show at least four ties) 8" WHITE PINE (BT) Fd. STEEL Post/sign 1' So. of HARRISON '96

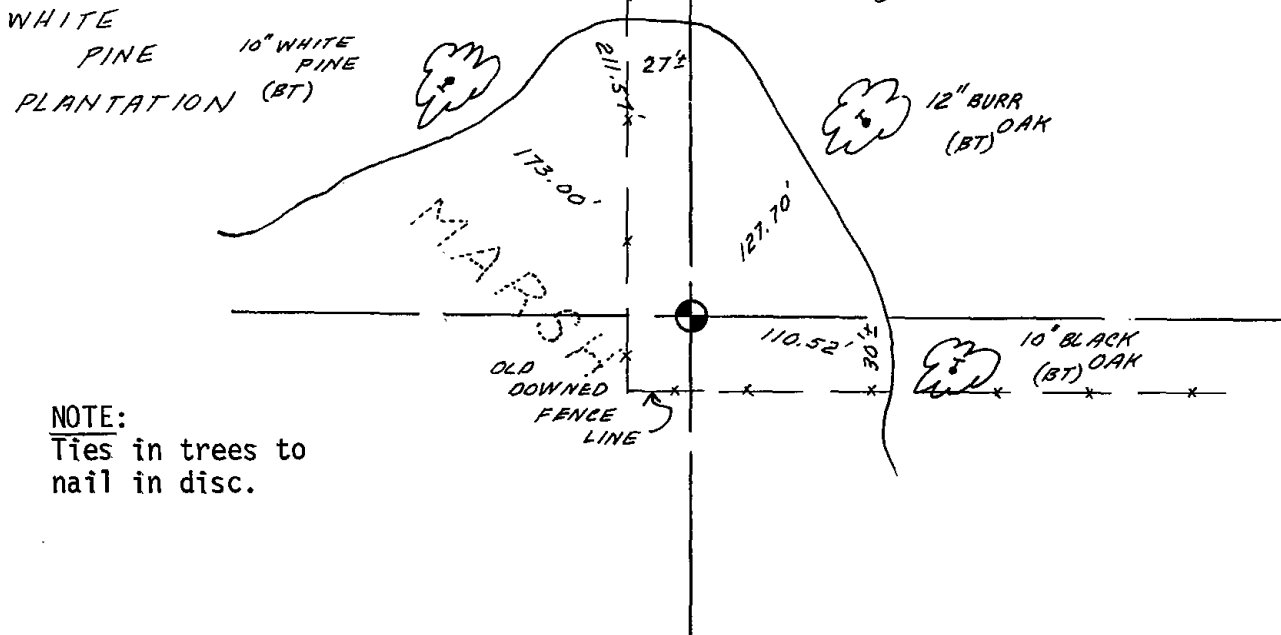

NOTE:
Ties in trees to nail in disc.