OT ADAMS COUNTY COUNTY CORNER NO: 31

ROMPORTOL ID: 41607020000

PUBLIC LAND SURVEY MONUMENT RECORD

HARRISON (BROKEN-TOP) TYPE OF MONUMENT:

ADAMS COUNTY COORDINATES, NAD 83 (2007)

N. 191240.299

E. 583878.471

ELEVATION-_ DATUM

FIELD WORK DATE: 08/18/2020


BASIS FOR MONUMENT LOCATION

1974 - PLS 1103 RAN EDM/T2 TRAVERSE OF SECTION 2, 3, AND 4 OF THE TOWN OF NEW CHESTER AND SECTION 34 AND 35 OF THE TOWN OF LINCOLN. THE CORNER WAS ESTABLISHED AFTER AN ANALYSIS OF THE ORIGINAL NOTES AND THE FIELD EVIDENCE, DID NOT EXCAVATE BECAUSE SEARCH AREA FELL IN SLIGHT CUT SECTION.

2020 - PLS 2675 FOUND HARRISON (BROKEN-TOP) 6"± BELOW THE GROUND AND 1 WITNESS. THE MONUMENT AGREES WITH THE EXISTING WITNESS. ACCEPTED THE HARRISON (BROKEN-TOP) AS THE CORNER LOCATION. SET 2 NEW TIES AND MEASURED TO 2 FOUND PROPERTY IRONS AND THE EXISTING WITNESS.



(INDICATE CORNER BY "X")

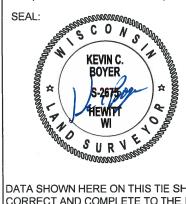

DATA SHOWN HERE ON THIS TIE SHEET IS CORRECT AND COMPLETE TO THE BEST OF MY KNOWLEDGE AND BELIEF.

PROFESSIONAL LAND SURVEYOR


3/2020 DATE_

-TIE SKETCH -

NOTE: THE CORNER LANDS 48.6 ± NORTH EAST OF S. EAGLE AVE./2ND AVE. CENTERLINE.



- SET 3/4" x 18" IRON REBAR, 1.50#/FT
- FOUND 3/4" IRON ROD
- FOUND HARRISON (BROKEN-TOP) MONUMENT
- STEEL FENCE POST
- VINYL "T" POST
- WITNESS TREE

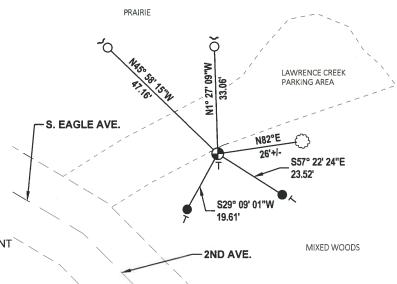

CORNER NO. . ADAMS COUNTY SECTION Survey Monument Record TOWN TYPE OF MONUMENT: Standard Harrison RANGE STATE PLANE COORDINATES: N. ELEVATION - M.S.L. DATUM: -THETA ANGLE: _ FIELD BOOK: ____ __ PAGE . BASIS FOR MONUMENT LOCATION (Use reverse side if necessary) LOCATION Show info such as: History of corner, with reference to Vol. and pg, dates, surveyor; exact description of monument replaced; if location computed, by taped or EDM traverse; landowner (Indicated by 'X') SEAL: Ran EDM/transit traverse of Sections 2, 3 and 4 of the Town of New Chester and Sections 34 and 35 of the Town of Lincoln. The corner was established after an analysis of the original notes and the field evidence. Did not excavate because search area fell in slight cut section. CORNER O.K. 2.24.77 6R-55 4-23-82 CERTIFIED CORRECT 12-12-86 KZ-55 12-23-91 OK 1-02-02 ML Registered Land Surveyo October DATE: OK 1-24-87-56 01-09-12 TIE SKETCH (Show at least four ties) NOTE Ties to nail in disc. SW CORNER TRANSFORMER BOX GROUND ^{ે 8}ે ક C EABLE 98-8ur Oak/87 برخيرى DIZ"BIK. Oak

REVISED 1974