16 TOWN

ADAMS COUNTY COUNTY CORNER NO: 36 ROMPORTOL ID: 41607082000

PUBLIC LAND SURVEY MONUMENT RECORD

HARRISON TYPE OF MONUMENT: ADAMS COUNTY COORDINATES, NAD 83 (2007)

N. 188514.530

E. 568843.019

ELEVATION-DATUM - -

FIELD WORK DATE: 09/16/2020

BASIS FOR MONUMENT LOCATION


1971 - PLS 981 FOUND NAIL AND PIPE, SET BOTTOM 20" OF HARRISON MONUMENT ON ROCK.

1977 - PLS 1108 THIS IS A RE-TIE OF CORNER SET BY SAM T. MULLEN.


2008 - PLS 2559 FOUND HARRISON MONUMENT 1.2' BELOW GRAVEL SURFACE AND ACCEPTED IT AS THE TRUE CORNER LOCATION. THEN SET ACCESSORIES.

2008 - PLS 2663 PRIOR TO ROAD CONSTRUCTION RECOVERED BOTTOM OF HARRISON MONUMENT CALLED FOR AND RECORDED ITS LOCATION. AFTER ROAD CONSTRUCTION WAS COMPLETED FOUND BOTTOM OF HARRISON MONUMENT INTACT ±1' BELOW THE ROAD SURFACE AND VERIFIED LOCATION. SET 3 NEW WITNESS MONUMENTS.

2020 - PLS 2675 FOUND MAG NAIL IN THE ROAD SURFACE, REMOVED AND FOUND HARRISON 24" BELOW THE ROAD SURFACE AND 4 TIES. THE MONUMENT AGREES WITH ALL 4 TIES, ACCEPTED THE HARRISON AS THE CORNER LOCATION, SET 1 NEW TIE AND MEASURED TO A FOUND RIGHT-OF-WAY IRON AND THE EXISTING TIES.

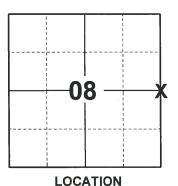

(INDICATE CORNER BY "X")

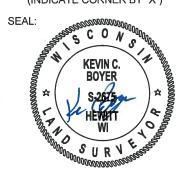

DATA SHOWN HERE ON THIS TIE SHEET IS CORRECT AND COMPLETE TO THE BEST OF MY KNOWLEDGE AND BELIEF.


PROFESSIONAL LAND SURVEYOR

-TIE SKETCH

NOTE: THE CORNER LANDS 7'± WEST OF 5TH AVE. CENTERLINE.



- SET 3/4" x 18" IRON REBAR, 1.50#/FT
- FOUND 3/4" IRON ROD
- FOUND 5/8" IRON ROD
- FOUND 1.00" O.D. IRON PIPE
- FOUND HARRISON MONUMENT
- **POWER POLE**
- RIGHT-OF-WAY GUARD POST

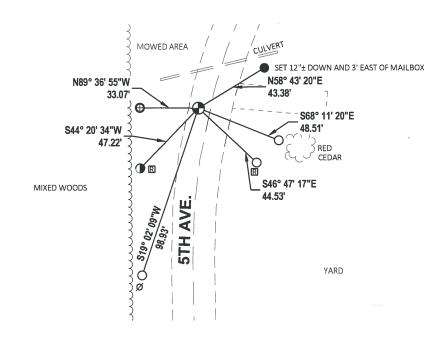

U. S. Public Land Survey I	Monument Record
ADAMS COUNTY	CORNER NO. 36
TYPE OF MONUMENT: Harrison Monument	SECTION 9
STATE PLANE COORDINATES: N	TOWN 16 N
E	RANGE 07 E
ELEVATION M.S.L. DATUM:	
THETA ANGLE:	
FIELD BOOK:	NW NE I
	*
BASIS FOR MONUMENT LOCATION	SW SE
(Use reverse side if necessary)	3 32
Show information such as: History of corner, with referen	
and pg. dates, surveyor; exact description of monument es	LOCATION
by you to perpetuate the location of this point, landowne	r remarks, etc. (Indicated by "X")
10-27-08 - I found a Harrison Monument 1.2' below grav	el surface and accepted it as
the true corner location. I then set access	
	19-SEPT-08
	O. KRANDWSKI
	5-31-77
	DALE MAGEN
SURVEYOR'S CERTIFICATE:	REID 14-Jacy 71
This is to certify that the corner location on this record	P Briggsville, WI & SAM MULLEN
was determined by or under my direction and control and that this US Land Survey Monument Record	S-2559 S-2559
is correct to the best of my knowledge and belief.	C. T.
James & Print 11000	ONAL LANDS

Jamey L. Reid RLS-2559

01-11-12 MS OK TIE SKETCH Set Punch hole (Show at least four ties) in 15" CMCP Not to Scale - Fd. Harrison Monument Fd. 1" Private Ent. Iron Pipe **#**2558 Ave. Prepared by Ayres Associates Fd. 3/4" 5†h 1802 Pankratz Street rebar Fd. 3/4" Madison, WI 53704 rebar phone: (608)-443-1200


Sheet 1 of 1

ADAMS COUNTY SURVEY MONUMENT RECORD GOVERNMENT CORNER: W1/4 SEC 9 T16N R7E TYPE OF MONUMENT: HARRISON STATE PLANE COORDINATES: N E ELEVATION: FIELD BOOK: PAGE	CORNER NO. 17 SECTION 9 TOWN 16 NORTH RANGE 7 EAST NEW CHESTER CITY, VILLAGE, TOWN
TAGE	 N

BASIS FOR CORNER LOCATION:

PRIOR TO ROAD CONSTRUCTION RECOVERED BOTTOM OF HARRISON MONUMENT CALLED FOR AND RECORDED ITS LOCATION. AFTER ROAD CONSTRUCTION WAS COMPLETED FOUND BOTTOM OF HARRISON MONUMENT INTACT ±1' BELOW THE ROAD SURFACE AND VERIFIED LOCATION THEN SET THREE NEW WITNESS MONUMENTS.

KRZANOWSKI S-2663 MOSINEE DATE: 19 SEPTEMBER 2008

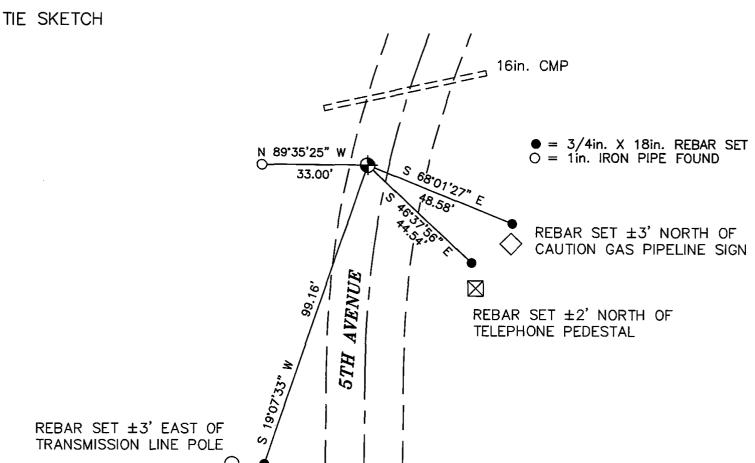

ADAMS COUNTY

Survey Monument Record

TYPE OF MONUMENT: Bop 20" of Harrison STATE PLANE COORDINATES: N.

ELEVATION - M.S.L. DATUM: _

THETA ANGLE:

PAGE _37 FIELD BOOK: _

BASIS FOR MONUMENT LOCATION


(Use reverse side if necessary)

Show info such as: History of corner, with reference to Vol. and pg, dates, surveyor; exact description of monument replaced; if location computed, by taped or EDM traverse; landowner remarks, etc.

This is a re-tie of corner set by Sam T. Mullen.

Re-tied on 4-4-77.

6R-55 3-22-82 COR. OK

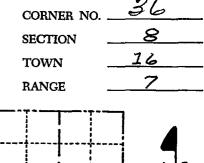




SEAL:



Registered Land Surveyor DATE:

TIE SKETCH

(Show at least four ties)

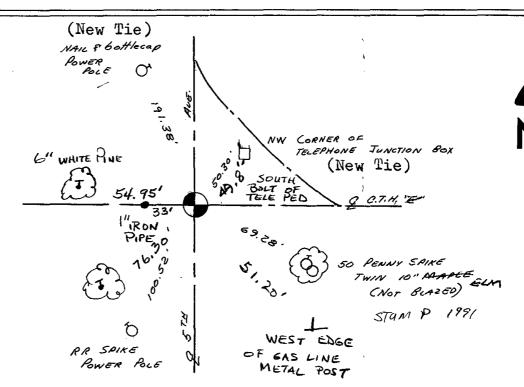

		(3
ADAMS COUNTY	CORNER NO	_17
Survey Monument Record	SECTION _	9
TYPE OF MONUMENT: 30" HARRISON	TOWN _	16
STATE PLANE COORDINATES: N	RANGE _	7
EELEVATION — M.S.L. DATUM: THETA ANGLE: FIELD BOOK: PAGE		
BASIS FOR MONUMENT LOCATION		
(Use reverse side if necessary)		i
Show info such as: History of corner, with reference to Vol. and pg, dates, surveyor; exact description of monument replaced; if location computed, by taped or EDM traverse; landowner remarks, etc.	LOCATION (Indicated by 'X')	J
Found nail and pipe and set bottom 20" of Harrison monument of	on rock	
July 14, 1971		
Sam T. Mullen R.L.S. S-981		
CORNER OF 4-82 GR. OR 11-26-86 GR. OK 11-26-86 GR. OK 11-26-86 GR. OK 3-90-85 GR. CERT CK 3-402-JG OK, 2-20-07-JG.	TFIED CORRECT:	
OK, 1-20-07-36 Regista	ered Land Surveyor	
DATE	J:	
TIE SKETCH (Show at least four ties)	OIRE LEFEBRONE SO	LE
6"WHITE PINE 6"WHITE PINE 54.95 54.95 FIRE DED		
	ry. "E"	·
6"Burr 5 16.30 ST.2- ORK OF GAS LINE METAL POST	R.R. Spike	
Power Power	ELM	

R.R. Spike