OT RANGE ADAMS COUNTY COUNTY CORNER NO: 39

ROMPORTOL ID: 41607112000

PUBLIC LAND SURVEY MONUMENT RECORD

HARRISON TYPE OF MONUMENT: ADAMS COUNTY COORDINATES, NAD 83 (2007)

N. 188597.870

E. 583892.772


ELEVATION-DATUM

FIELD WORK DATE: 08/31/2020

BASIS FOR MONUMENT LOCATION

1976 - PLS 1103 EXCAVATED WITH BACKHOE AT LOCATION INDICATED BY TIE TO ORIGINAL BEARING TREE, THE STUMP HOLE OF WHICH WAS POINTED OUT BY LOCAL LANDOWNER, DARWIN PODOLL. EXCAVATION YIELDED BOTTOM 6" OF POINTED 2" DIAMETER DRIVEN STAKE, WHICH MATCHED TIE TO STUMP HOLE OF BEARING TREE TO NORTHEAST. REPLACED POST WITH HARRISON MONUMENT.

2020 - PLS 2675 FOUND HARRISON FLUSH WITH THE ROAD SURFACE AND DID NOT RECOVER ANY EXISTING TIES OR WITNESSES. ACCEPTED THE HARRISON AS THE BEST AVAILABLE EVIDENCE OF THE CORNER LOCATION. SET 4 NEW TIES.

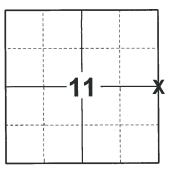

LOCATION

(INDICATE CORNER BY "X")



MIXED WOODS

DATA SHOWN HERE ON THIS TIE SHEET IS CORRECT AND COMPLETE TO THE BEST OF MY KNOWLEDGE AND BELIEF.


PROFESSIONAL LAND SURVEYOR

2020

- TIE SKETCH

NOTE: THE CORNER LANDS 6'± SOUTH OF EAGLE DR. CENTERLINE AND 13'± WEST OF 2ND AVE. CENTERLINE.



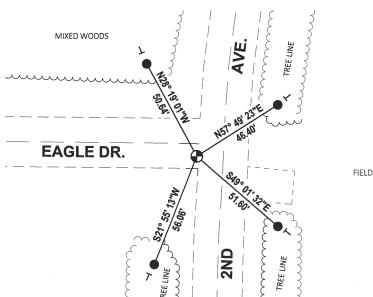

- SET 3/4" x 18" IRON REBAR, 1.50#/FT
- FOUND HARRISON MONUMENT
- VINYL "T" POST

CORNER NO. . ADAMS COUNTY SECTION Survey Monument Record 16 TYPE OF MONUMENT: Harrison Monument TOWN RANGE STATE PLANE COORDINATES: N_ \mathbf{E} ELEVATION -- M.S.L. DATUM: . THETA ANGLE: . FIELD BOOK: __ PAGE . BASIS FOR MONUMENT LOCATION DALE C. HAGEN S-1103 Wisconsin Rapids, Wis. (Use reverse side if necessary) Show info such as: History of corner, with reference to Vol. and pg, dates, surveyor; exact description of monument replaced; if location computed, by taped or EDM traverse; landowner SEAL: remarks, etc. Excavated with backhoe at location indicated by tie to original bearing tree, the stump hole of which was pointed out by local landowner, Darwin Podoll. Excavation yieldedbbottom 6" of pointed 2" diameter driven stake, which matched tie to stump hole of bearing tree to Northeast. Replaced post with Harrison Monument of 7-8-76. COR OK 4-12-82 12-12 -06 CORNER O.K. Z-24-77 6R-55 OK 12-23-91 KZ-55 CERTIFIED CORRECT: OK - 1-02-02 Registered Land Surveyor OK, 2-20-07-56 DATE: 12-1-76 Twin 12" and 6' TIE SKETCH Blk Oakl-nail on (Show at least four ties) East side of 12" NOTE Ties in trees to nail in disc. G EAGLE "Blk Oakfar

