16

ADAMS COUNTY COUNTY CORNER NO: 42 ROMPORTOL ID: 41607070020

PUBLIC LAND SURVEY MONUMENT RECORD

HARRISON TYPE OF MONUMENT: ADAMS COUNTY COORDINATES, NAD 83 (2007)

N. 185847.511

E. 560088.984


ELEVATION-DATUM - —

FIELD WORK DATE: 09/17/2020


BASIS FOR MONUMENT LOCATION

1976 - PLS 878 EXCAVATED LARGE AREA WITH BACKHOE. COULD FIND NO EVIDENCE OF MONUMENTATION, POINT SET ON LINE IN PROPORTION TO ORIGINAL NOTES. NO RESURVEYS ON RECORD.

2020 - PLS 2675 FOUND HARRISON 12"± BELOW THE DRIVEWAY SURFACE AND DID NOT RECOVER ANY EXISTING TIES OR WITNESSES. ACCEPTED THE HARRISON AS THE BEST AVAILABLE EVIDENCE OF THE CORNER LOCATION AND SET 4 NEW TIES.

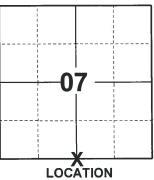

(INDICATE CORNER BY "X")

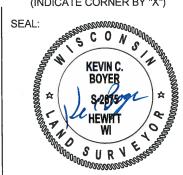

DATA SHOWN HERE ON THIS TIE SHEET IS CORRECT AND COMPLETE TO THE BEST OF MY KNOWLEDGE AND BELIEF.


PROFESSIONAL LAND SURVEYOR

12020

-TIE SKETCH

NOTE: THE CORNER LANDS 12'± SOUTH OF EDGEWOOD AVE. CENTERLINE.



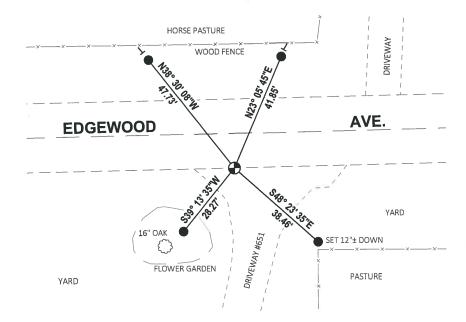

SET 3/4" x 18" IRON REBAR, 1.50#/FT

FOUND HARRISON MONUMENT

VINYL "T" POST

CORNER NO. ADAMS COUNTY **SECTION** Survey Monument Record TOWN TYPE OF MONUMENT: Harrison standard RANGE STATE PLANE COORDINATES: N_ E. ELEVATION - M.S.L. DATUM: _ THETA ANGLE: __ FIELD BOOK: PAGE . BASIS FOR MONUMENT LOCATION (Use reverse side if necessary) LOCATION Show info such as: History of corner, with reference to Vol. and pg, dates, surveyor; exact description of monument replaced; if location computed, by taped or EDM traverse; landowner (Indicated by 'X') SEAL: remarks, etc. ANTHONY B. KIEDROWSKI S-878 Wisconsin Rapids, Wis. Excavated large area with backhoe. Could find no evidence of monumentation. Point set on line in proportion to original notes. No resurveys on record. 3-8-77 GR-55 CORNER 3.22-82 CERTIFIED CORRECT: 11-26-86 11 12-6R 12-26-91 Registered Land Surveyor DATE. 1/23/76 56 12-27-96 10 ML 11 2-26-07-OK 01-17-12 MS TIE SKETCH (Show at least four ties) Q Edgewood 40 29.18 8"Black S 65 M 8" BLACK OAK

REVISED 1974

