16 TOWN

# ADAMS COUNTY COUNTY CORNER NO: 48

### PUBLIC LAND SURVEY MONUMENT RECORD

TYPE OF MONUMENT:_	HARRIS	ON	
ADAMS COUNTY COOR	DINATES, NAD 83 (	(2007)	9
N. 185921	.524		
E. 575971	.961		
ELEVATION	DATUM		
FIELD WORK DATE:	09/16/2020		

#### BASIS FOR MONUMENT LOCATION


1976 - PLS 1103 RAN EDM/TRANSIT TRAVERSE AROUND SECTION 10 TO ADJACENT SECTION CORNERS. EXCAVATION WITH BACKHOE YIELDED NO EVIDENCE OF THE ORIGINAL CORNER OR ANY EVIDENCE OF REMONUMENTATION OF THE CORNER. SET CORNER EQUIDISTANT AND ON LINE BETWEEN THE SOUTHEAST AND SOUTHWEST CORNERS OF SECTION 10.

2008 - PLS 2663 PRIOR TO ROAD CONSTRUCTION OF CTH "E", FOUND STANDARD HARRISON MONUMENT IN PLACE AND RECORDED LOCATION. AFTER THE ROAD CONSTRUCTION OF CTH "E" WAS COMPLETED, FOUND SAID HARRISON MONUMENT UN-DISTURBED. ±4" BELOW THE ROAD SURFACE. SET SURVEY MARKER PIN (SMP) IN NEW BITUMINOUS OVER HARRISON MONUMENT AND FOUR NEW WITNESS MONUMENTS.


2008 - PLS 2559 FOUND SURVEY MARKER NAIL AT SURFACE AND ACCEPTED IT AS THE TRUE CORNER LOCATION. BELIEVED THE MONUMENT WAS REMOVED OR COVERED DURING THE CTH "E" CONSTRUCTION (2008). THEN ESTABLISHED ACCESSORIES.

2020 - PLS 2675 FOUND HARRISON 4"± BELOW THE ROAD SURFACE AND 4 TIES. THE MONUMENT AGREES WITH ALL 4 TIES. ACCEPTED THE HARRISON AS THE CORNER LOCATION. MEASURED TO A FOUND PROPERTY IRON AND THE 4 EXISTING TIES.

ELEC. PEDESTAL

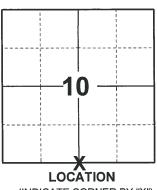

(INDICATE CORNER BY "X")

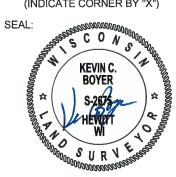


DATA SHOWN HERE ON THIS TIE SHEET IS CORRECT AND COMPLETE TO THE BEST OF MY KNOWLEDGE AND BELIEF.

PROFESSIONAL LAND SURVEYOR 3/2020

#### -TIE SKETCH

NOTE: THE CORNER LANDS 3'± SOUTH OF CTH "E" CENTERLINE.



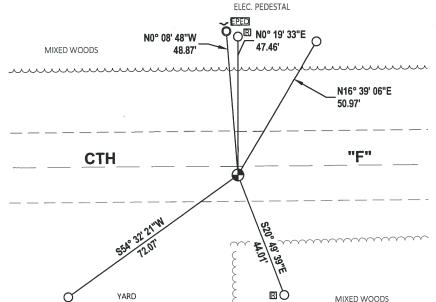

- FOUND 3/4" IRON ROD
- FOUND 1-1/4" O.D. IRON PIPE
- FOUND HARRISON MONUMENT
- STEEL FENCE POST
- RIGHT-OF-WAY GUARD POST

## U. S. Public Land Survey Monument Record

ADAMS COUNTY	CORNER NO. 48
TYPE OF MONUMENT: Survey Marker Nail	SECTION 10
STATE PLANE COORDINATES: N	TOWN 16 N
E	RANGE 07 E
ELEVATION M.S.L. DATUM:	
THETA ANGLE:	
FIELD BOOK:	NW ! NE
	I I NAA   I NE"
	<del></del>
BASIS FOR MONUMENT LOCATION	SW   SE
(Use reverse side if necessary)	
Show information such as: History of corner, with reference to Vol.	<del></del>
and pg. dates, surveyor; exact description of monument established	LOCATION
by you to perpetuate the location of this point. Landowner remarks.	etc. (Indicated by "X")
January 23, 1976 - Dale C. Hagen ran EDM / transit traverse aroum	· · · · · · · · · · · · · · · · · · ·
to adjacent Section Corners. Excavation yielded no evidence of or	
evidence of a remonumented corner. Set corner (Standard Harrison	<del>-</del>
equidistant and on line between the Southeast and Southwest corn	
10-27-08 - I found a Survey Marker Nail at surface and accepted .	it as the true corner leasting
I believe the monument was removed or covered during	
I then established accessories as shown.	***************************************
	SEE TIE SHEET
SURVEYOR'S CERTIFICATE:	19-SEPT '08 O, KRZANOWSKI
This is to certify that the corner location on this record was determined by or under my direction and control	EYL. KRZANOWSKI
and that this US Land Survey Monument Record	
is cogrect to the best of my knowledge and belief.	ille, Wi Be B
S-28	550 <i>S.C.</i>
Jamey 2 Keid 11-18-08	The state of the s
Jomey L. Reid RLS-2559	AND SULL OK OI-11-12 MS
TIE CVETCU	24432
TIE SKETCH (Show at least four ties)	• •
Not to Scale	
101 10 30010	
N i	3.82
516	50.82
- Fd. Survey Marker Nail	// CTH E
3'	
● - Fd.¾" rebar	
Northeast Corner of	چ \
Power transformer at base.	\\\\\\\\\\\\\\\\\\\\\\\\\\\\\\\\\\\\\\
13.	\
Prepared by Ayres Associates	_
1802 Pankratz Street	•
Madison, WI53704	
phone: (608)-443-1200 Sheet 1 of 1	

#### CORNER NO. \_ ADAMS COUNTY SECTION Survey Monument Record TYPE OF MONUMENT: Standard Harrison 16 TOWN . RANGE · STATE PLANE COORDINATES: N. ELEVATION - M.S.L. DATUM: \_ THETA ANGLE: \_ \_ PAGE \_ FIELD BOOK: \_\_\_ BASIS FOR MONUMENT LOCATION (Use reverse side if necessary) LOCATION Show info such as: History of corner, with reference to Vol. and pg, dates, surveyor; exact description of monument replaced; if location computed, by taped or EDM traverse; landowner (Indicated by 'X') SEAL: remarks, etc. Ran EDM/transit traverse around Section 10 and to adjacent section corners. Excavation with backhoe yielded no evidence of DALE C the original corner or any evidence of remonumentation HAGEN of the corner. \$-1103 Wisconsin Rapids, Set corner equidistant and on line between the Southeast and Southwest corners of Section 10. CORNER 0.K. 2-24-77 GR-SS 1, 11 4-20-82 CERTIFIED CORRECT: 12-12-86 GR Registered Land Surveyor January 23 12-30-91 CR-56 1- NEW TIE 6K, 1-20-07-5G (Show at least four ties) NOTE: Ties in trees and poles to nail in disc. Q C.T.H.


i 

.

# ADAMS COUNTY SURVEY MONUMENT RECORD GOVERNMENT CORNER: S 1/4 SEC

GOVERNMENT CORNER: S 1/4 SEC 10 T16N R7E
TYPE OF MONUMENT: HARRISON
STATE PLANE COORDINATES: N
E

ELEVATION:
FIELD BOOK: PAGE

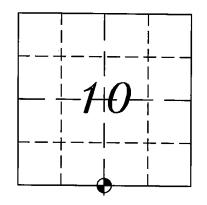

CORNER NO. 907

SECTION 10 TOWN 16 NORTH RANGE 7 EAST

NEW CHESTER CITY, VILLAGE, TOWN



BASIS FOR CORNER LOCATION:

PRIOR TO ROAD CONSTRUCTION OF CTH E, FOUND STANDARD HARRISON MONUMENT IN PLACE AND RECORDED LOCATION. AFTER THE ROAD CONSTRUCTION OF CTH E WAS COMPLETED, FOUND SAID HARRISON MONUMENT UN-DISTURBED, ±4 INCHES BELOW THE ROADS SURFACE.

SET SURVEY MARKER PIN (SMP) IN NEW BITUMINOUS OVER HARRISON MONUMENT AND FOUR NEW WITNESS MONUMENTS



