16

OT RANGE ADAMS COUNTY COUNTY CORNER NO: 49 ROMPORTOL ID: 41607100000

PUBLIC LAND SURVEY MONUMENT RECORD

HARRISON TYPE OF MONUMENT: ADAMS COUNTY COORDINATES, NAD 83 (2007)

N. 185920.338

E. 578615.692


ELEVATION-DATUM

09/16/2020 FIELD WORK DATE:


BASIS FOR MONUMENT LOCATION

1976 - PLS 1103 RAN EDM/TRANSIT TRAVERSE AROUND SECTION 10 AND TO ADJACENT GOVERNMENT CORNERS. EXCAVATION WITH BACKHOE YIELDED NO EVIDENCE OF ANY REMONUMENTATION OF THE ORIGINAL CORNER OR THE ORIGINAL CORNER ITSELF. SET CORNER BY DOUBLING OVER LINE BETWEEN THE NORTHEAST AND EAST QUARTER CORNER OF THIS SECTION 10. THIS LOCATION FITS THE SURROUNDING PHYSICAL EVIDENCE QUITE WELL.

2020 - PLS 2675 FOUND MAG NAIL IN THE ROAD SURFACE, REMOVED AND FOUND HARRISON 8"± BELOW THE ROAD SURFACE. DID NOT RECOVER ANY EXISTING TIES OR WITNESSES. THE MONUMENT WAS VERIFIED TO BE CORRECT BY DOUBLING OVER THE LINE BETWEEN THE NORTHEAST AND EAST QUARTER CORNER OF SECTION 10. ACCEPTED THE HARRISON AS THE CORNER LOCATION, SET 2 NEW TIES AND MEASURED TO 2 FOUND RIGHT-OF-WAY IRONS.

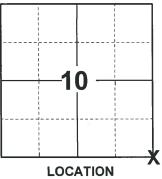

(INDICATE CORNER BY "X")

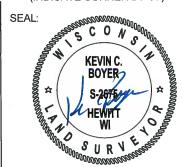

DATA SHOWN HERE ON THIS TIE SHEET IS CORRECT AND COMPLETE TO THE BEST OF MY KNOWLEDGE AND BELIEF.


PROFESSIONAL LAND SURVEYOR

20 70


-TIE SKETCH

NOTE: THE CORNER LANDS 3.3'± EAST OF CTH "G" CENTERLINE AND 17.1'± SOUTH OF CTH "E" CENTERLINE.



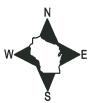

- SET 3/4" x 18" IRON REBAR, 1,50#/FT
- FOUND 3/4" IRON ROD
- FOUND HARRISON MONUMENT
- VINYL "T" POST
- RIGHT-OF-WAY GUARD POST

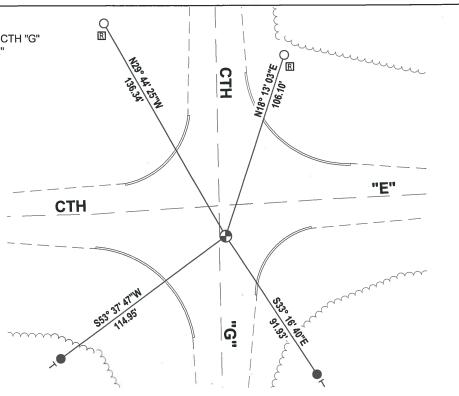

CORNER NO. ADAMS COUNTY SECTION Survey Monument Record 16 TOWN TYPE OF MONUMENT: Standard Harrison RANGE STATE PLANE COORDINATES: N. E ELEVATION — M.S.L. DATUM: _ THETA ANGLE: . FIELD BOOK: ... _ PAGE BASIS FOR MONUMENT LOCATION (Use reverse side if necessary) LOCATION Show info such as: History of corner, with reference to Vol. and pg, dates, surveyor; exact description of monument replaced; if location computed, by taped or EDM traverse; landowner Ran EDM/transit traverse around Section 10 and to adjacent government corners. Excavation with backhoe yielded no evidence of any remonumentation of the original corner or the original corner itself. Set corner by doubling over line between the Northeast and East Quarter corner of this? Section 10. This location fits the surrounding physical evidence quite well. CORNER 0.K. 2.24.77 6R.55 n O. K. 4-20-82 " 12-12-86 612-Registered Land Surveyor DATE: January 12-30-91 GR-50-,/ 12-10-96 55 TIE SKETCH 2-20-07-36 (Show at least four ties) of NEW TIES 01-11-12 MS O NOTE: Ties in trees and GONE poles to nail Power in disc. "E" **,**8 12 POWER POLÉO NAIL 4' MIGH

OSTRET GONE