# OT RANGE ADAMS COUNTY COUNTY CORNER NO: 51 ROMPORTOL ID: 41607110000

## PUBLIC LAND SURVEY MONUMENT RECORD

**HARRISON** TYPE OF MONUMENT: ADAMS COUNTY COORDINATES, NAD 83 (2007)

N. 185948.076

E. 583893.596

**ELEVATION-**DATUM

09/01/2020 FIELD WORK DATE:

#### BASIS FOR MONUMENT LOCATION

1977 - PLS 1103 RAN EDM/T2 TRAVERSE AROUND SECTIONS 1 AND 12, AND PORTIONS OF ADJACENT SECTIONS TO DETERMINE SEARCH AREA FOR INVESTIGATION. EXCAVATION YIELDED P.K. NAIL IN BLACKTOP, BUT NO OTHER EVIDENCE OF THE LOCATION OF THE CORNER. ACCEPTED NAIL AS CORNER (SEE HOLZMILLER'S SURVEYS TO THE SOUTHEAST OF THIS CORNER), AND REPLACED WITH HARRISON.

2020 - PLS 2675 FOUND MAG NAIL IN THE ROAD SURFACE AND DID NOT RECOVER ANY EXISTING WITNESSES OR TIES. REMOVED THE MAG NAIL AND FOUND A HARRISON 6"± BELOW THE ROAD SURFACE, ACCEPTED THE HARRISON AS THE BEST AVAILABLE EVIDENCE OF THE CORNER LOCATION AND SET 4 NEW TIES.



(INDICATE CORNER BY "X")




DATA SHOWN HERE ON THIS TIE SHEET IS CORRECT AND COMPLETE TO THE BEST OF MY KNOWLEDGE AND BELIEF.

PROFESSIONAL LAND SURVEYOR

#### -TIE SKETCH

NOTE: THE CORNER LANDS .7'± EAST OF 2ND AVE. AND 2.5'± NORTH OF CTH "E".



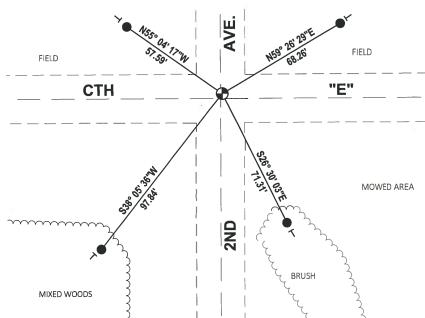

- SET 3/4" x 18" IRON REBAR, 1.50#/FT
  - FOUND HARRISON MONUMENT
- VINYL "T" POST

### CORNER NO. \_ ADAMS COUNTY **SECTION** Survey Monument Record TOWN TYPE OF MONUMENT: Harrison RANGE STATE PLANE COORDINATES: N. E ELEVATION - M.S.L. DATUM: . THETA ANGLE: \_ \_ page <u>58</u> FIELD BOOK: \_\_\_ BASIS FOR MONUMENT LOCATION LOCATI Indicated by DALE C. HAGEN S-1103 Wisconsin Rapids Wis. (Use reverse side if necessary) Show info such as: History of corner, with reference to Vol. and pg, dates, surveyor; exact description of monument replaced; if location computed, by taped or EDM traverse; landowner remarks, etc. Ran EDN/T2 traverse around Sections 1 and 12, and portions of adjacent sections to determine search area for investigation. Excavation yielded P.K. Nail in blacktop, but no other evidence of the location of the corner. Accepted nail as corner (See Holzmiller's surveys to the Southeast of this corner), and replaced with Harrison on 7-8-76. 6R-55 4-12-82 OK COR. KZ-55 12-23-91 CERTIFIED CORRECT 12-10-96 1-09-02 ML Registered Land Surveyor 2-20-87 - JC 01-1172 MS DATE: 5-31-77 TIE SKETCH (Show at least four ties) 32"8410 STUNDE Oak NOTE POWER POLET 012 Ties in trees to nail in disc. POWER Œ 3/4" REBAL-Blogs csm . De. Da.

*त* श (0) 12"Burr Oaklor

