16

OT ADAMS COUNTY COUNTY CORNER NO: 55

ROMPORTOL ID: 41607182000

PUBLIC LAND SURVEY MONUMENT RECORD

HARRISON (BROKEN-TOP) TYPE OF MONUMENT: ADAMS COUNTY COORDINATES, NAD 83 (2007)

N. 183243.074

E. 562732.085


- — _ DATUM_ **ELEVATION-**

09/29/2020 FIELD WORK DATE:


BASIS FOR MONUMENT LOCATION

1979 - PLS 878 NO RESURVEYS OF RECORD. EXCAVATED WITH BACKHOE. FOUND 5"X7"X14" POINTED BLUE GRANITE STONE DOWN 18" LOWERED STONE AND SET HARRISON ON TOP. LOCATION VERIFIED BY EDM TRAVERSE.

2020 - PLS 2675 FOUND HARRISON (BROKEN-TOP) 6" BELOW THE ROAD SURFACE AND 1 WITNESS. THE MONUMENT AGREES WITH THE WITNESS. ACCEPTED THE HARRISON (BROKEN-TOP) AS THE CORNER LOCATION. SET 4 NEW TIES AND MEASURED TO THE EXISTING WITNESS.

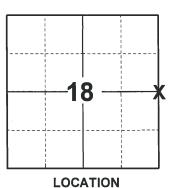

(INDICATE CORNER BY "X")

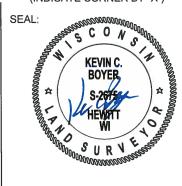


DATA SHOWN HERE ON THIS TIE SHEET IS CORRECT AND COMPLETE TO THE BEST OF MY KNOWLEDGE AND BELIEF.

PROFESSIONAL LAND SURVEYOR

-TIE SKETCH

NOTE: THE CORNER LANDS ON THE CENTERLINE OF 6TH AVE.



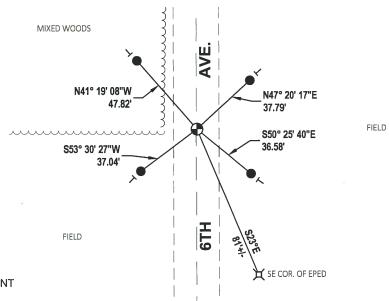

- SET 3/4" x 18" IRON REBAR, 1.50#/FT
- FOUND HARRISON (BROKEN-TOP) MONUMENT
- VINYL "T" POST

Government Land Corner Certificate

ADAMS	Cou	nty	
TYPE OF MONUMENT:H	ARRIS	2 Ň	
STATE PLANE COORDINATES:			
•	E		
ELEVATION — M.S.L. DATUM THETA ANGLE:			
FIELD BOOK: 57	PAGE	93	
DRAWN BY: B.S.			

CORNER NO. **SECTION** TOWN RANGE





BASIS FOR MONUMENT LOCATION


Show info such as: History of corner, with reference to Vol. and pg., dates, surveyor; exact description of monument replaced; if location computed, by taped or EDM traverse; landowner remarks, etc. (Use reverse side if necessary)

No resurveys of record. Excavated with backhoe. Found 5 x 7 x 14" pointed blue granite stone down 18". Lowered stone and set Harrison on top. Location verified by EDM traverse.

3-22-82 6R-55 12-10-86 GR OK KZ-GR

> 1-6197 JG-55 11 12-14-01 ML

SEAL:

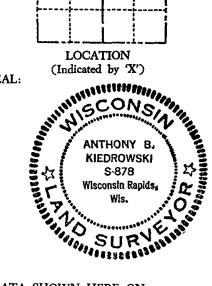


DATA SHOWN HERE ON CERTIFIED CORRECT:

hom 7B Registered Land Surveyor

5/11/79 DATE:

TIE SKETCH

Show at least four ties, also fence lines, roads, topo, size and type of witness trees' and if off road - best way to arrive at corner.

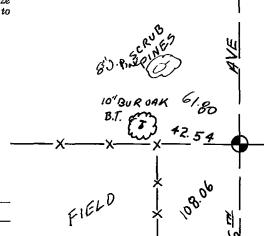

BUR OAK

B.T.

"BLACK OAK BT.

MAINTENANCE RECORD

Date	Init.	Remarks		
5-15-07		CoR	OK	
1-18-12	MS	OK		
		<u> </u>		
				

8" BLACK DAK BT. CONE

SE COR. 18492 ELEC

REVISED 1977

Box